


T.6S. R.2W. W.M.

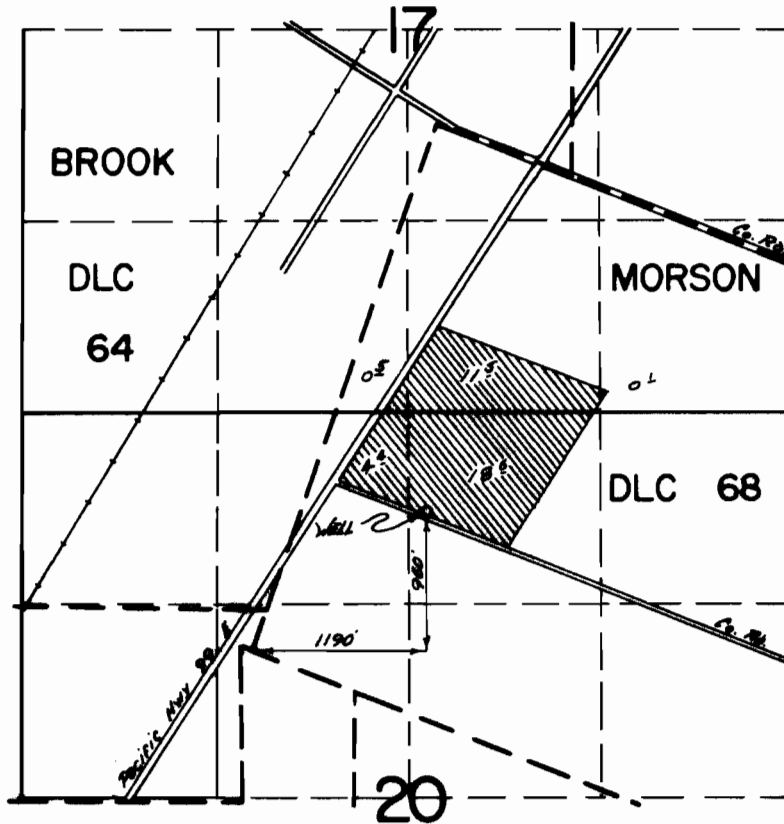

FINAL PROOF SURVEY
UNDER

Application No. G-4911... Permit No. G-4628.
IN NAME OF

MAXINE FOLEY, JOHN J., & MARGARET CARY

Surveyed April 8, 1974, by I. J. PAUL.....