


T.5S. R2W W.M.

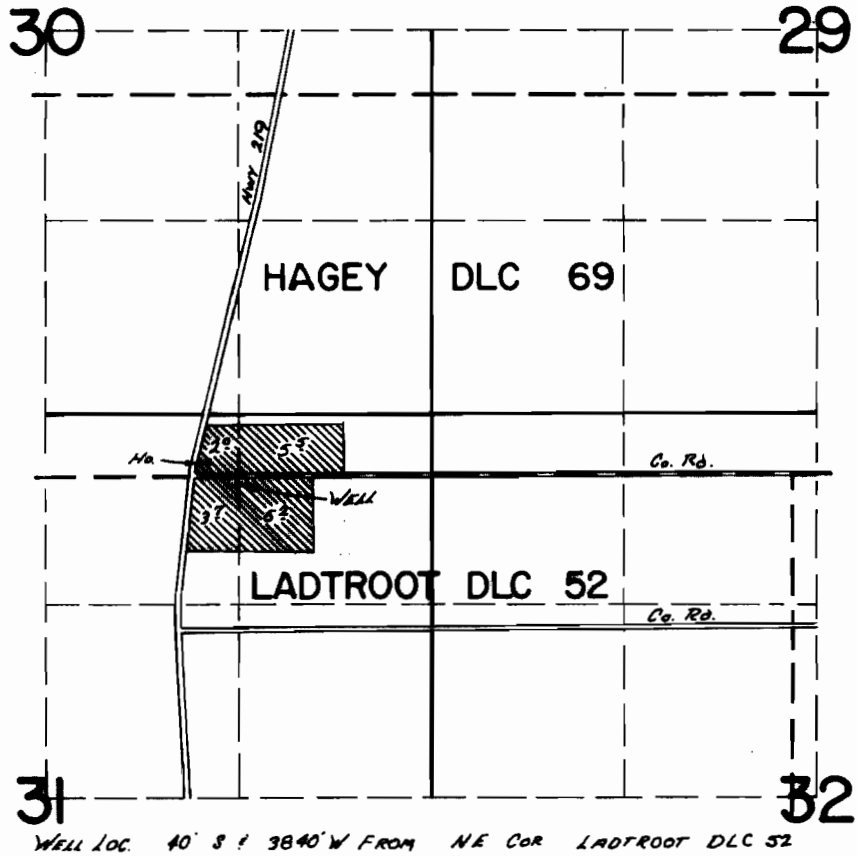

**FINAL PROOF SURVEY**  
UNDER

Application No. G-6066 Permit No. G-5197...  
IN NAME OF

.....STEWART L. STAIR.....

Surveyed April 9, 1974, by T. J. PAUL.....