T.7S. R.2E. W.M.

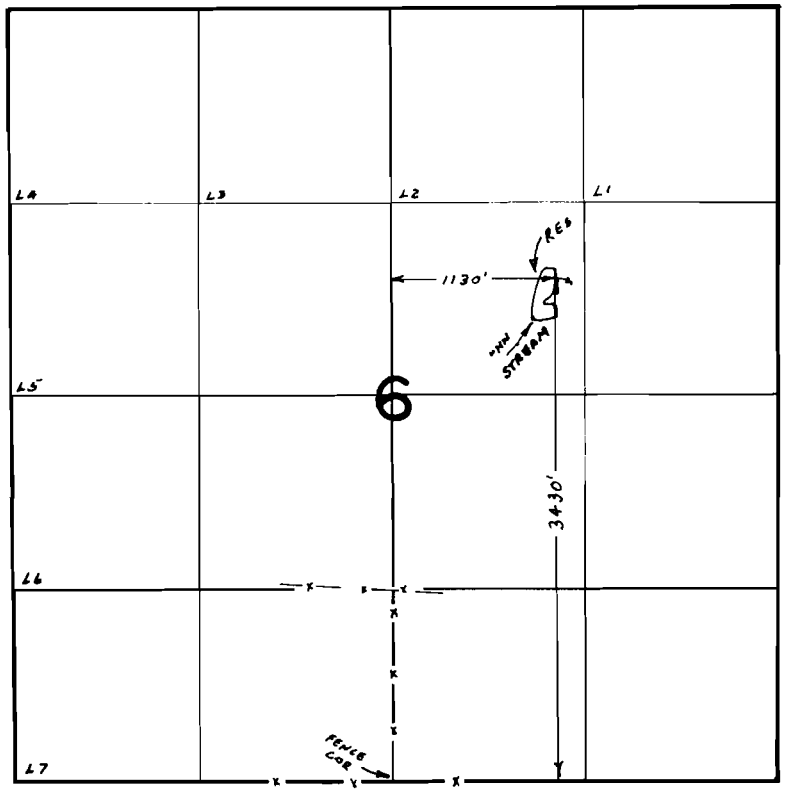

FINAL PROOF SURVEY
UNDER

R-40492 R-4628
Application No. 40493 Permit No. 30709
IN NAME OF

JOE SCHONBACHLER

Surveyed MAY 28 1974, by LH NUNN

1974-R LHN