


T.7S.R.2E.W.M.

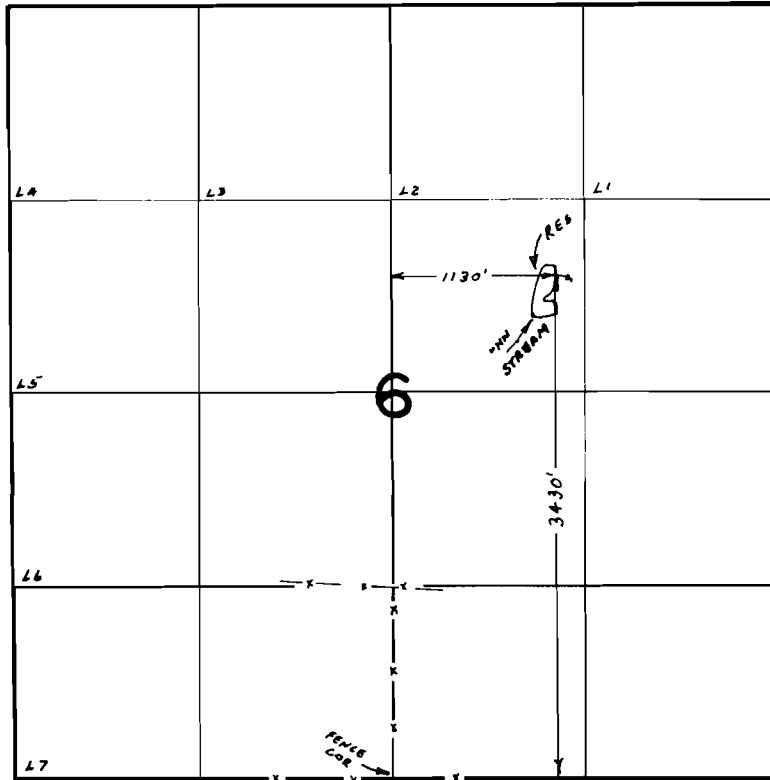

FINAL PROOF SURVEY UNDER

R-40492 R-4628
Application No. 40493 Permit No. 30709
IN NAME OF

JOE SCHONBACHLER

Surveyed MAY 28, 1974, by L.H. NUNN