


T.7S.,R.3W.,W.M.

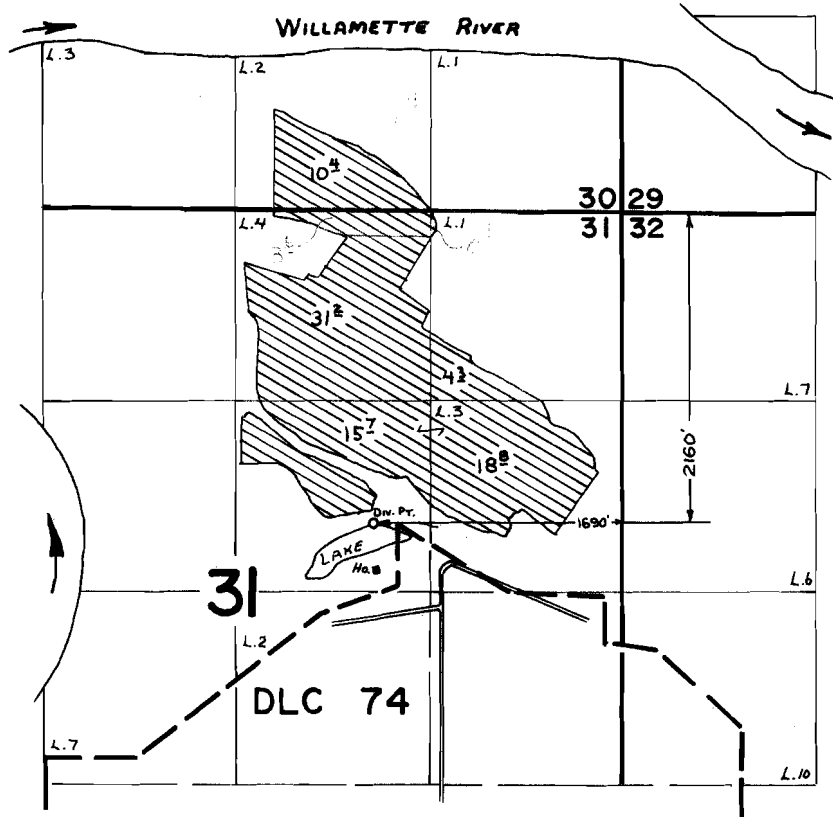

FINAL PROOF SURVEY UNDER

Application No. 54523 40892
44702 Permit No. 33328
IN NAME OF

KARL HEYDEN

Surveyed SEPT. 6, 1974, by L. TOLL
INSPECTED OCT. 3, 1977, BY L.H. NUNN