


T.7S. R.2E. W.M.

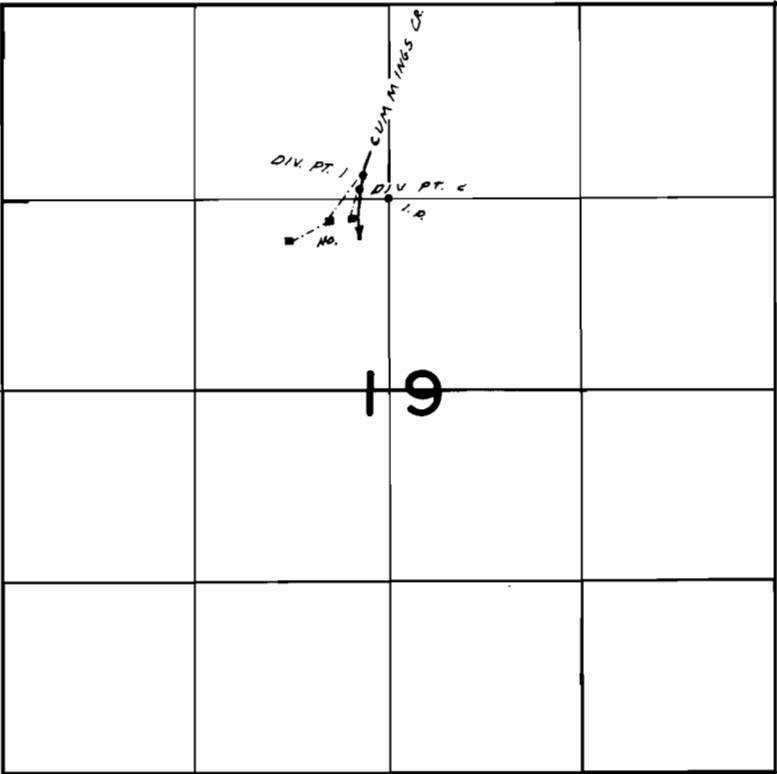

DIV. PT. LOC. 1- 160' N. & 170' W, 2- 70' N & 200' W
BOTH FROM SE COR., NE 1/4 NW 1/4, SEC. 19

FINAL PROOF SURVEY
UNDER

Application No. 45333 Permit No. 33838
IN NAME OF

WILLIAM H. CUMMINGS

Surveyed MAY 31 1974, by L.H. NUNN