


T.7S. R.1E. W.M.

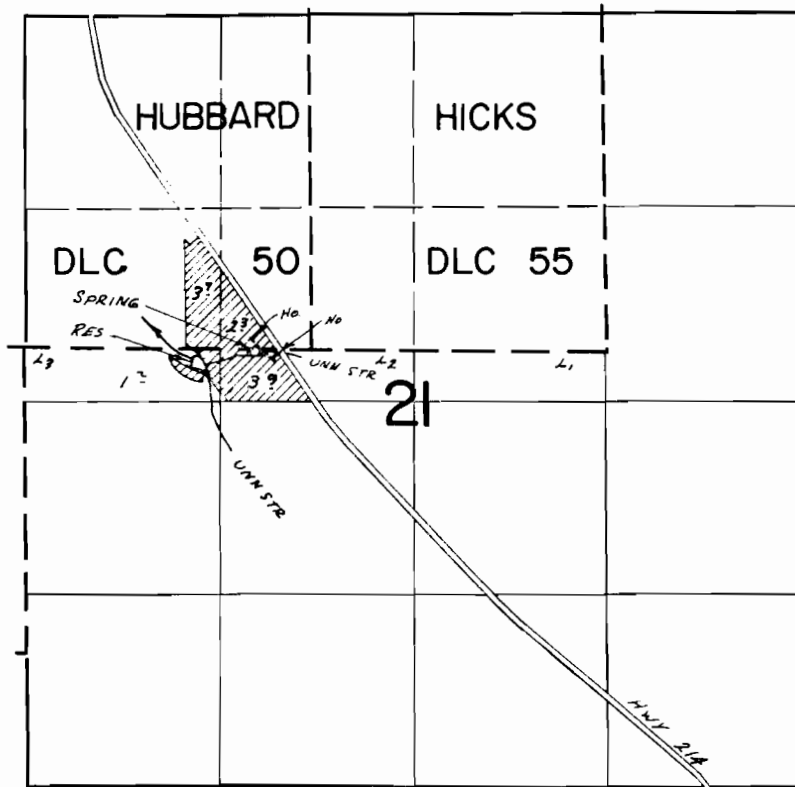

SPRING Loc 340' N & 1560' E RES. Loc 350' N & 1140' E BOTH FROM
W 1/4 COR. SECTION 21

FINAL PROOF SURVEY
UNDER

R-47442 R-5718
Application No. 47443 Permit No. 35546
IN NAME OF

ELDON MULKEY

Surveyed Oct. 4 1974, by T. J. PAUL