


T.6S.,R.1W.,W.M.

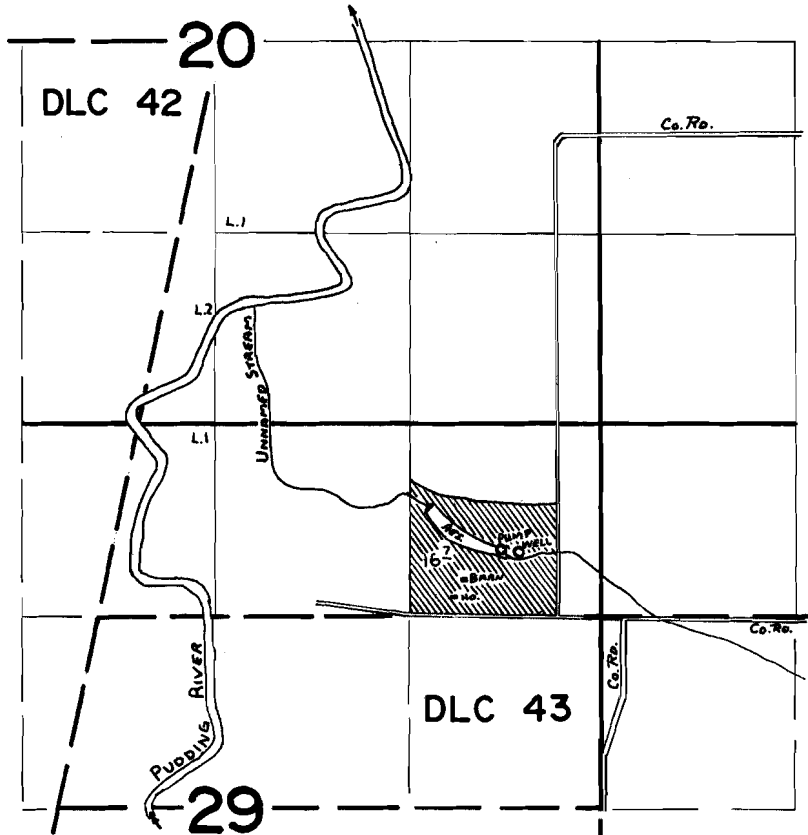

DAM Loc: 660' S AND 1160' W FROM NE COR. SEC 29
WELL Loc: 870' S AND 560' W FROM NE COR. SEC 29

FINAL PROOF SURVEY UNDER

R-48631 R-5815
Application No. 48413 Permit No. 35962
IN NAME OF

.....JAMES.....BEYER.....

Surveyed SEPT. 4. 1974, by L. TOLL.....