


T6S. R. 1E. W. M.

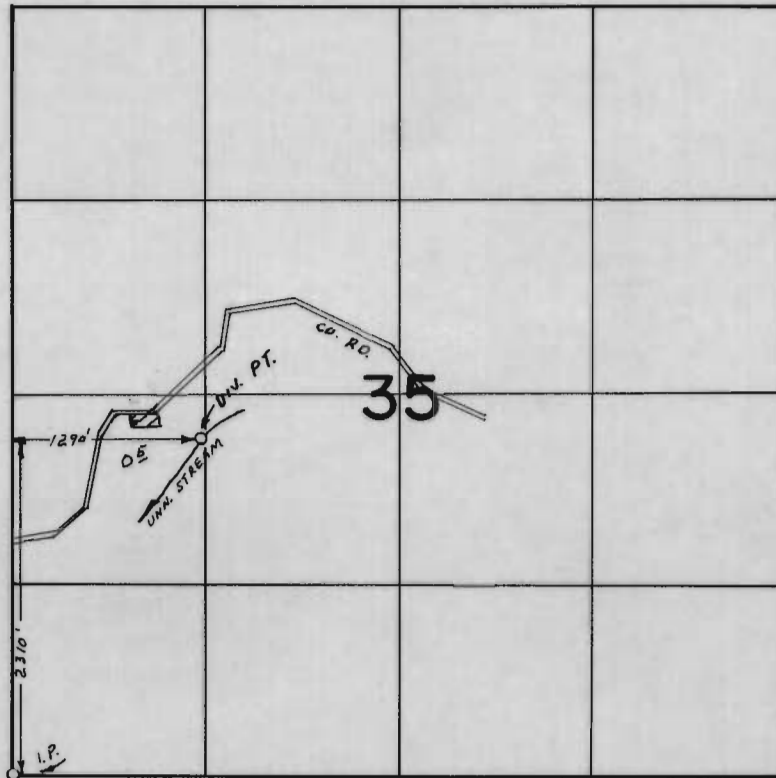

FINAL PROOF SURVEY
UNDER

Application No. 49498 Permit No. 37069
IN NAME OF

JOHN D. McKILLOP

Surveyed MAY 28 1974, by LH NUNN