


T.16&2N.R.26E.W.M.

G-3792

43515

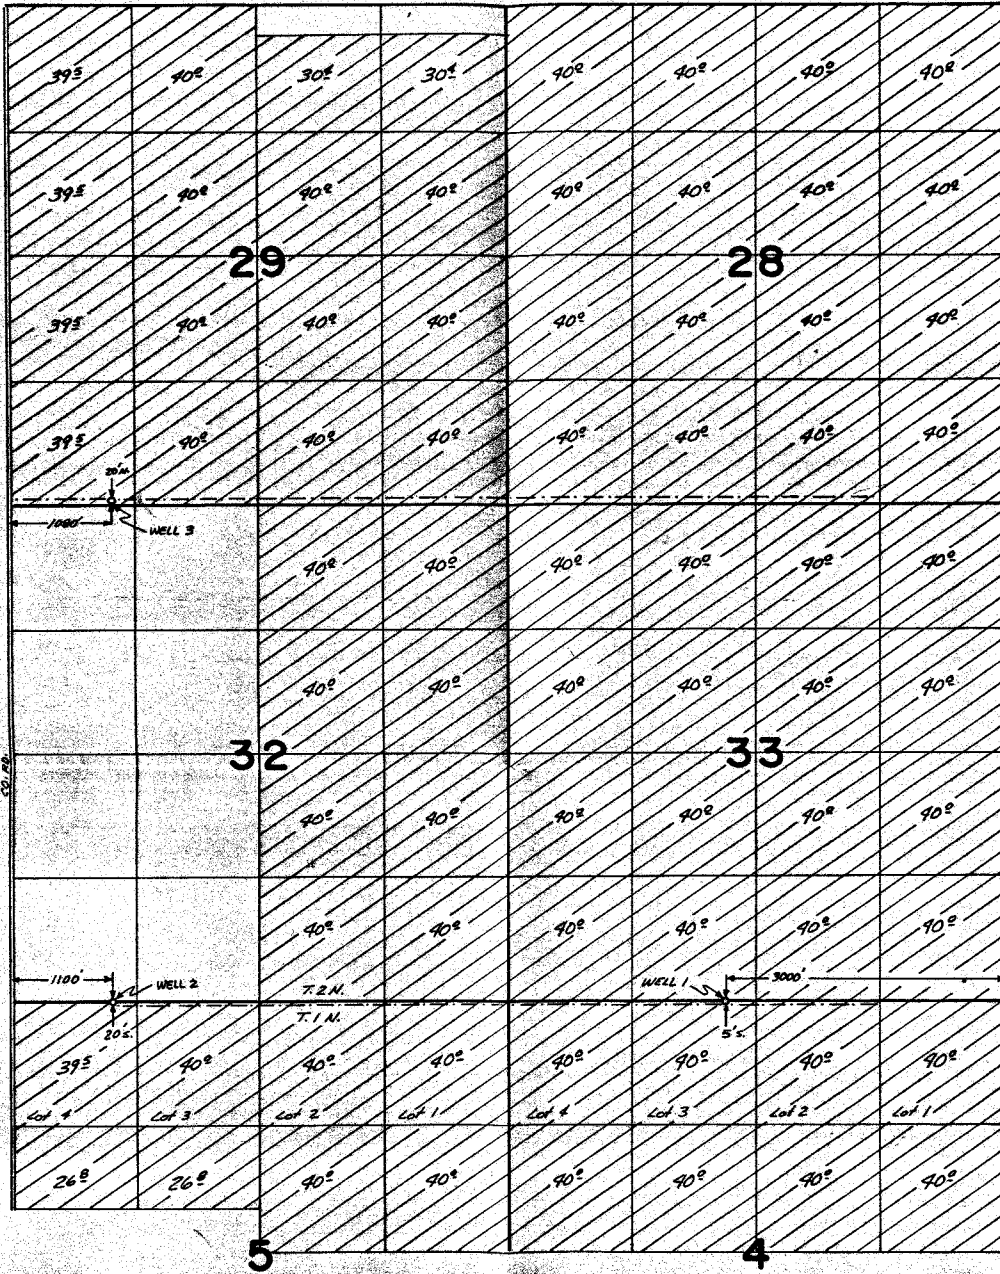

**FINAL PROOF SURVEY**

UNDER

Application No. G.3799 Permit No. G.3792

IN NAME OF

G.R.D. & H. GRIEB

Surveyed APRIL 18 1974, by D. Norby