


T.6S. R.7W. W.M.

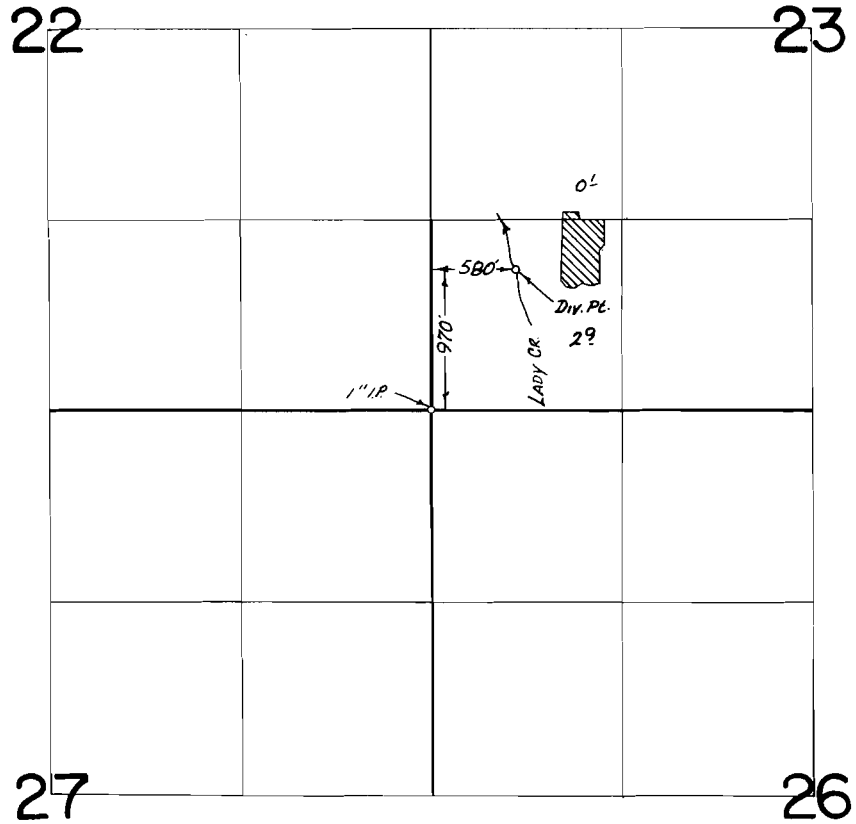

FINAL PROOF SURVEY
UNDER

Application No. 47290... Permit No. 35433...
IN NAME OF


Surveyed Oct...8... 1974, by T. J. PAUL.....