


T.3N.,R.9W.,W.M.

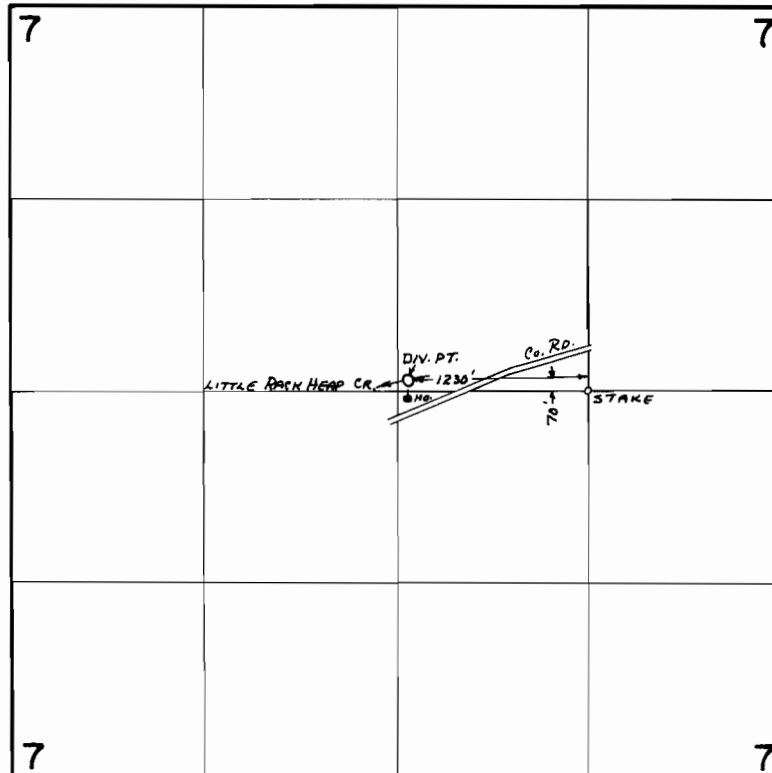

FINAL PROOF SURVEY
UNDER

Application No. 47033 Permit No. 35180
IN NAME OF

EARL HUFFMAN

Surveyed JUNE 28 1974, by D. NORBY