


T.1N.,R.9W.,W.M.

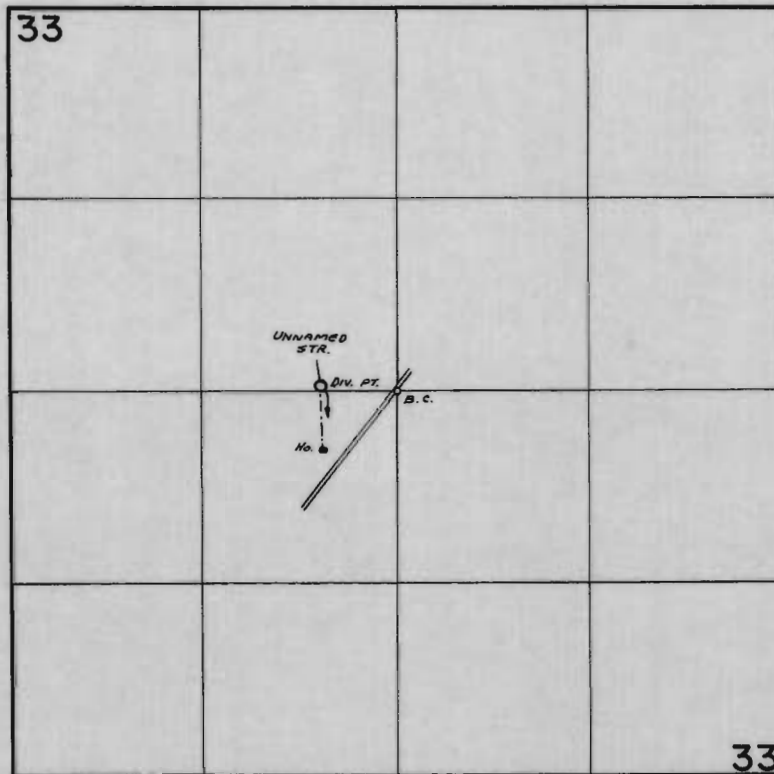

Div. Pt. Loc- 20' N AND 630' W FROM C/4 COR. SEC. 33

FINAL PROOF SURVEY
UNDER

Application No. **47620** ... Permit No. **35643** ...
IN NAME OF

JOHN S. CHRISTENSEN

Surveyed **JUNE 26 1974**, by **D. NORBY**