


T.2N.R.4W.W.M.

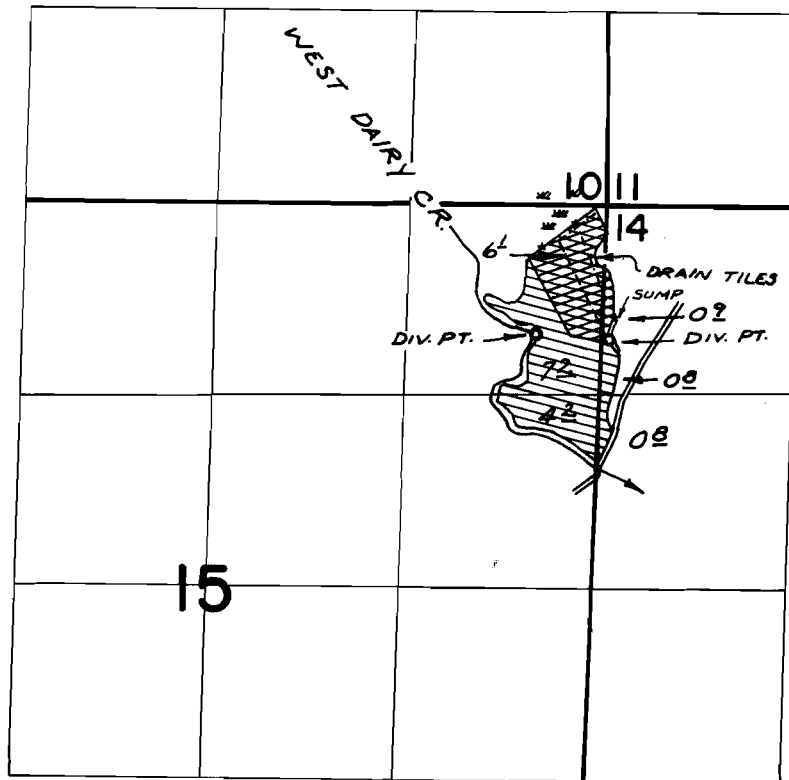

DIV. PTS. LOC: W. FK. DAIRY CR. - 880'S. & 450'W;
SUMP - 930'S. & 50'E, BOTH FROM NE COR. SEC. 15

FINAL PROOF SURVEY
UNDER

Application No. G-5137 44704 Permit No. G-4782 34901
IN NAME OF

THOMAS J. MALONEY

Surveyed APR. 4, 1974, by R. MUGGEN