


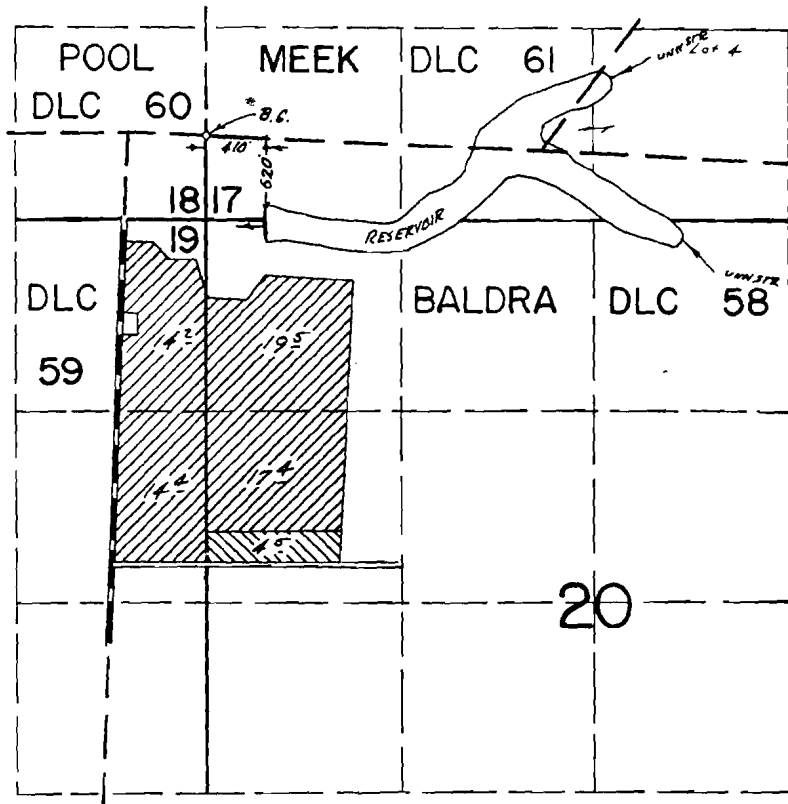

T.1N. R.2W. W.M.



 Primary
 Supplemental

FINAL PROOF SURVEY UNDER

R-38718 R-4545
Application No. ...38719... Permit No. ...3Q256
IN NAME OF

BURT VANDER ZANDEN

Surveyed April...2... 1974, by R...G...MUCKEN