


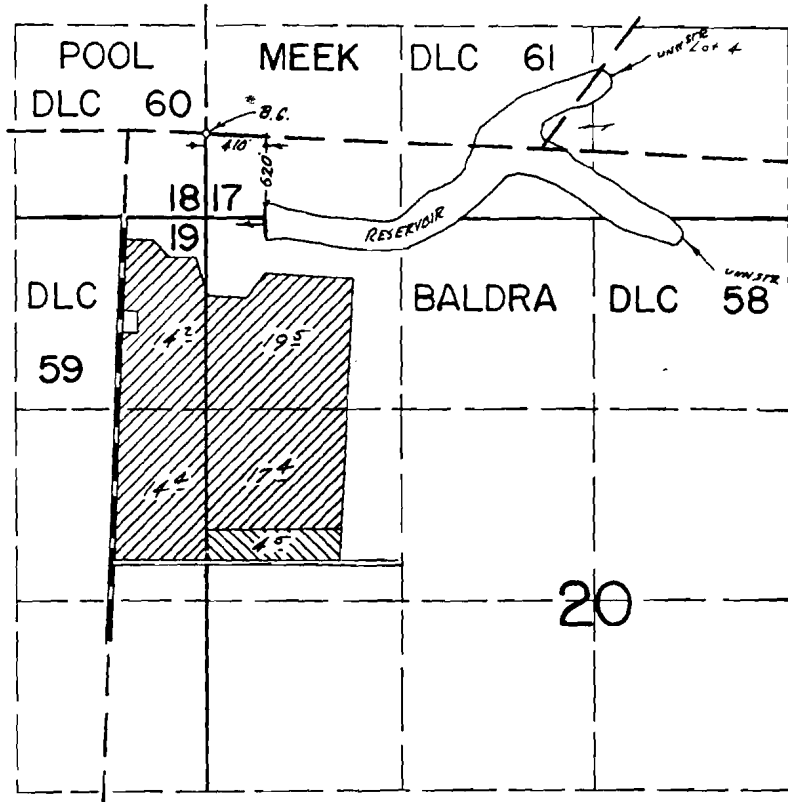

T.1N. R.2W. W.M.



 Primary  
 Supplemental

**FINAL PROOF SURVEY**  
UNDER

R-38718                      R-4545  
Application No. ...38719... Permit No. ...3Q256  
IN NAME OF

BURT VANDER ZANDEN

Surveyed April...2... 1974, by R...G...MUCKEN