


T.2S. R.2W. W.M.

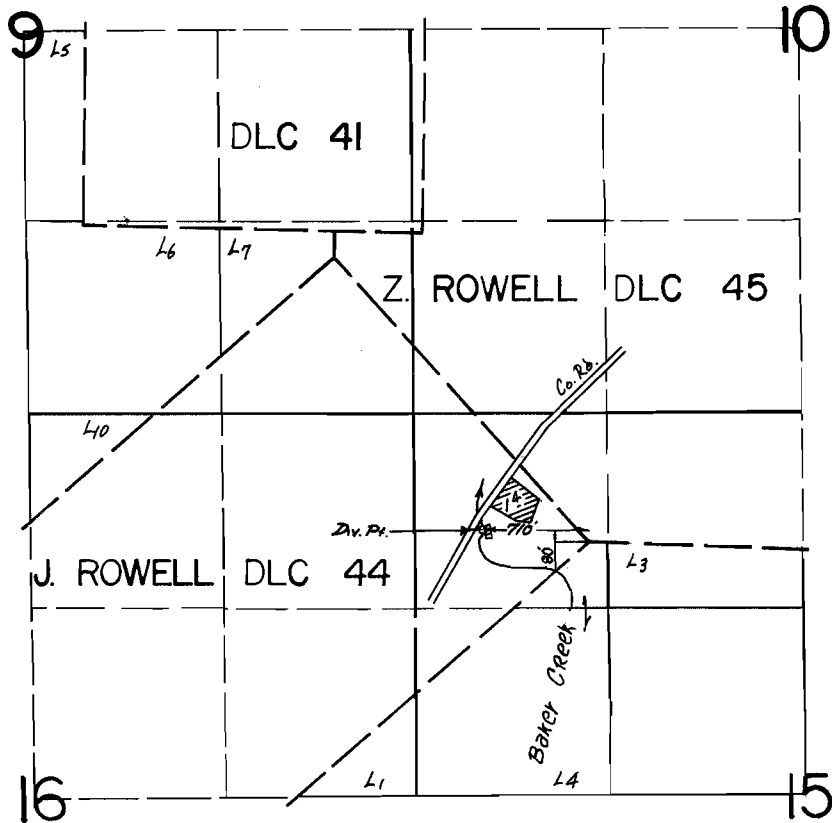

**FINAL PROOF SURVEY**  
UNDER

Application No. 40763... Permit No. 30356...  
IN NAME OF

CHARLES A. LUSARDI

Surveyed June 19, 1974, by R. G. MUCKEN