


T.1S. R.3W. W.M.

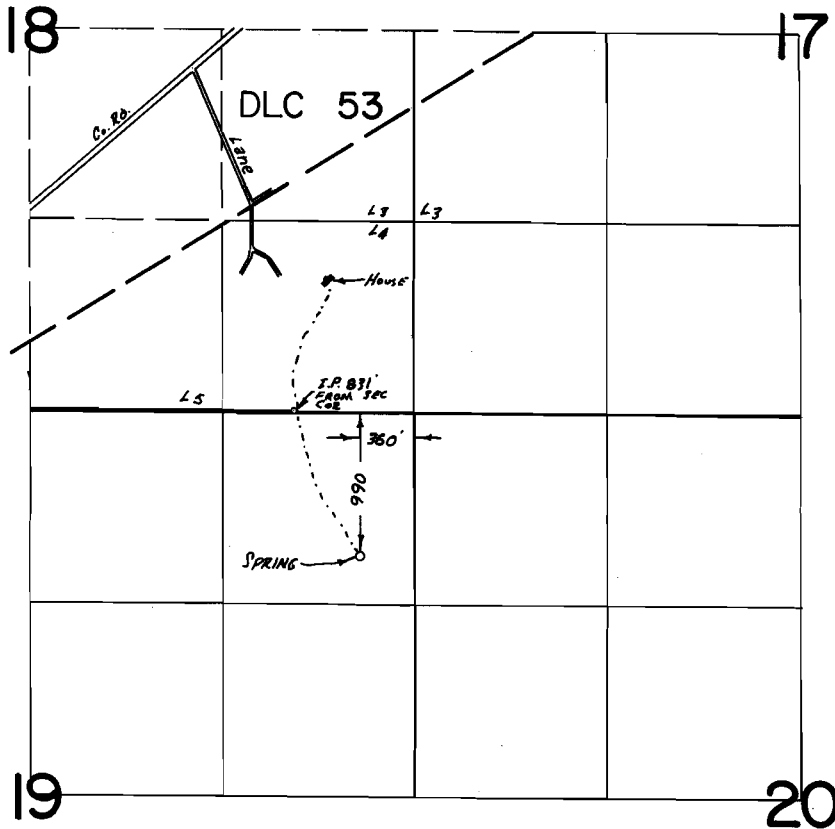

**FINAL PROOF SURVEY**  
UNDER

Application No. 41006... Permit No. 30632...  
IN NAME OF

DR. EDWIN ARLAND NOYES

Surveyed Oct...2... 1974, by R.G. MUCKEN