


T.2S. R.2W. W.M.

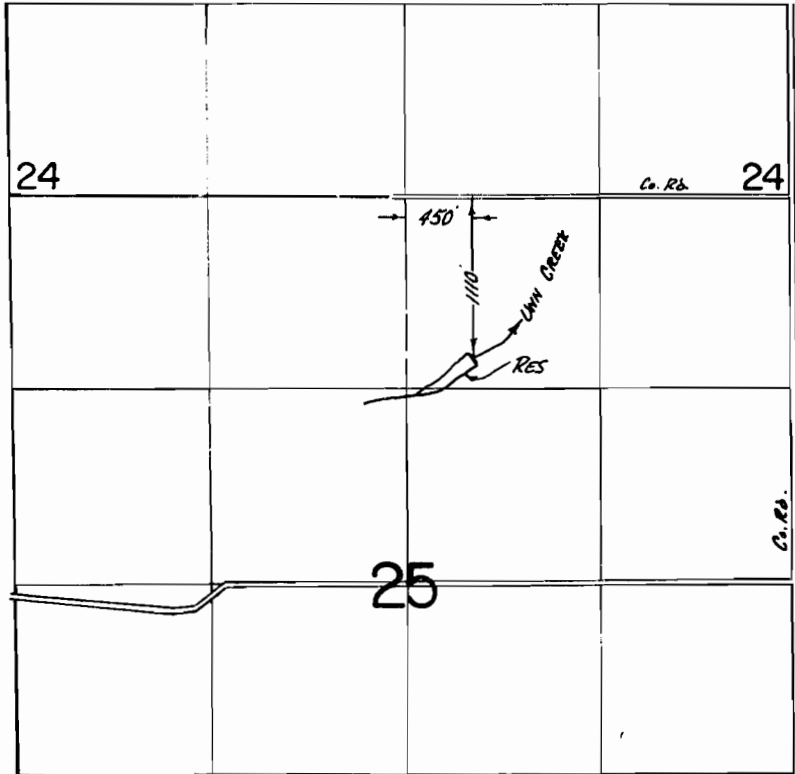

**FINAL PROOF SURVEY**  
UNDER

R-45313                      R-5349  
Application No. 45233 Permit No. 33791  
IN NAME OF

ESTATE OF JACK D. GODWIN

Surveyed May 14, 1974, by R. G. MUCKEN