


T.2S. R.2W. W.M.

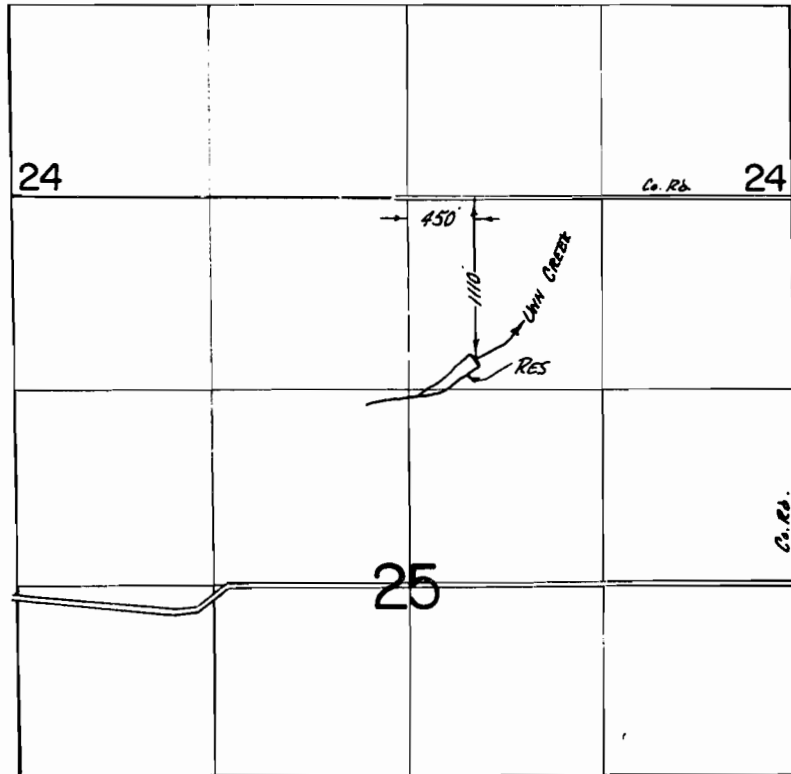

FINAL PROOF SURVEY
UNDER

R-45313 R-5349
Application No. 45233.. Permit No. 33791..
IN NAME OF

ESTATE OF JACK D. GODWIN

Surveyed May...14. 1974, by R...G...MUCKEN