


T.2S. R.1W. W.M.

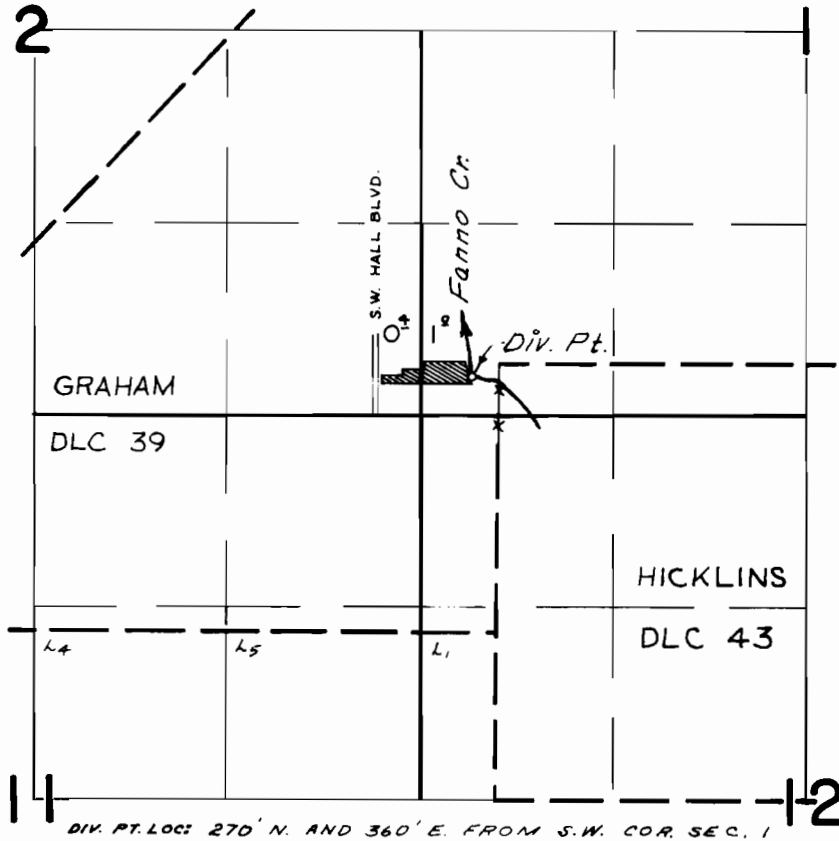

**FINAL PROOF SURVEY**  
UNDER

Application No. 47168 Permit No. 35312  
IN NAME OF

E. J. LEASON

Surveyed May 13, 1975, by R. Mucken