


# T.13 & 14S., R. 7 W., W.M.

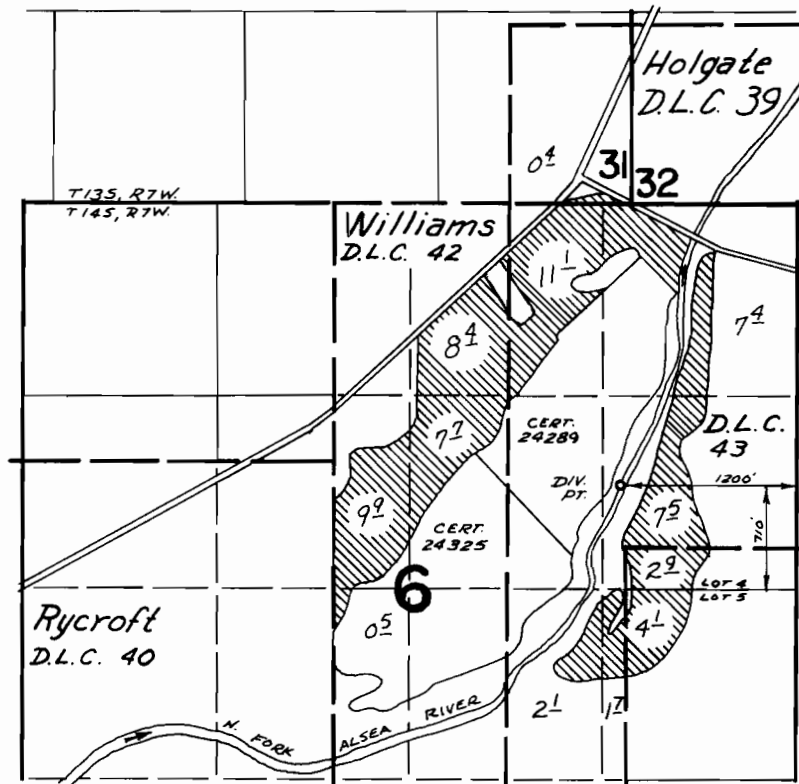

## FINAL PROOF SURVEY UNDER

Application No. 46884 Permit No. 35053  
IN NAME OF

*JOHN and MARGUERITE O'BRIEN*

Surveyed APR. 27, 1973, by D. NORBY