


T. 28 S. R. 6 W. W.M.

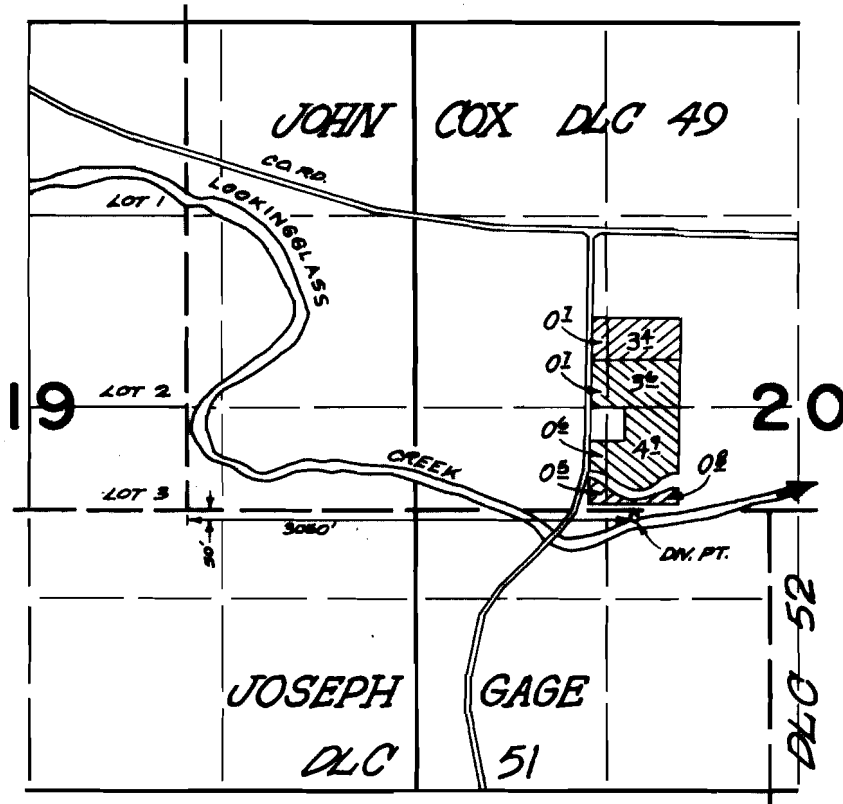

FINAL PROOF SURVEY
UNDER

TRANSFER NO. 2674

Application No. 49465 Permit No. 37053

IN NAME OF

EDWIN D. COLLINS

Surveyed JUNE 17 1974, by D. NORBY

