


T.27S.R.6W.W.M.

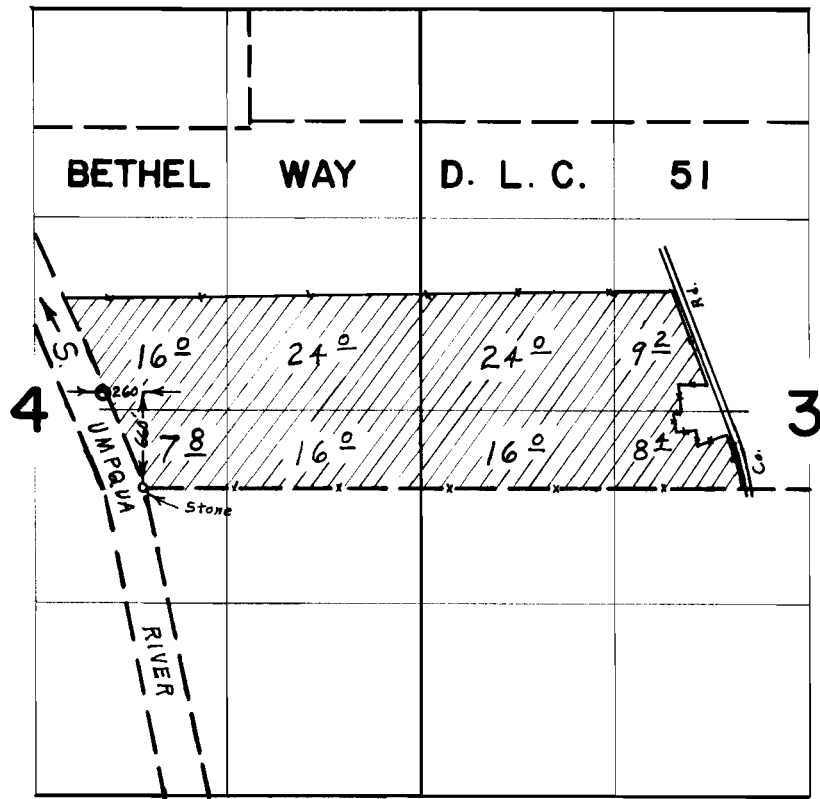

FINAL PROOF SURVEY UNDER

Application No. 37557. Permit No. 27985.
IN NAME OF
G. W. TIPTON

Surveyed May 19, 1966, by L. E. Gould.