


RECEIVED

JUL 10 1977

WATER RESOURCES DEPT  
SALEM, OREGON

T.30 S. R.3 W. W.M.

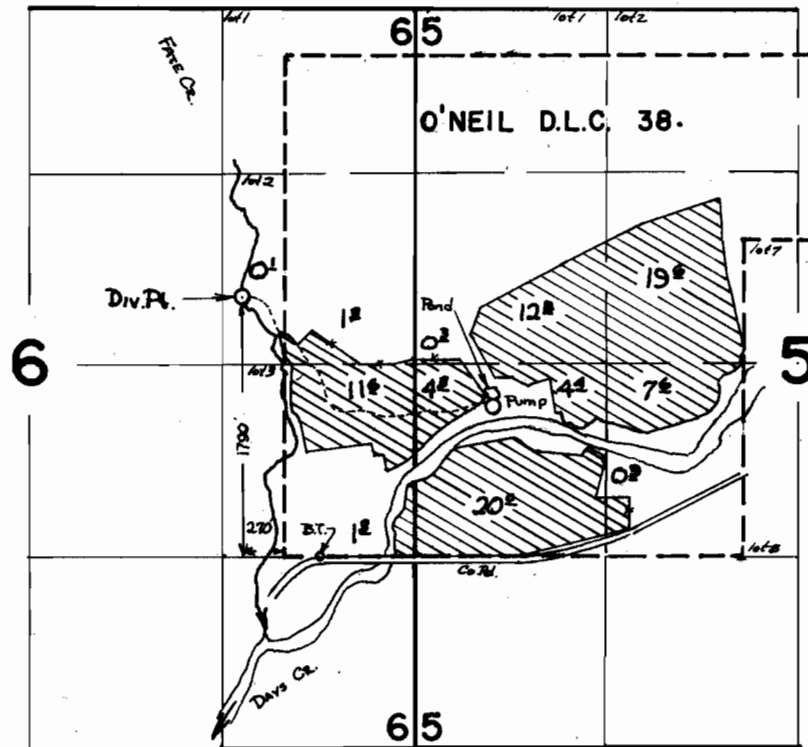

# FINAL PROOF SURVEY

UNDER

Application No. 44956 Permit No. 33602

IN NAME OF

FATE CREEK RANCH CORP.

Surveyed 2 JUNE 1970, by D. R. BUELL