


T-2468

SP O. V. 207494

T. 1 N. R. 19 E. W. M.

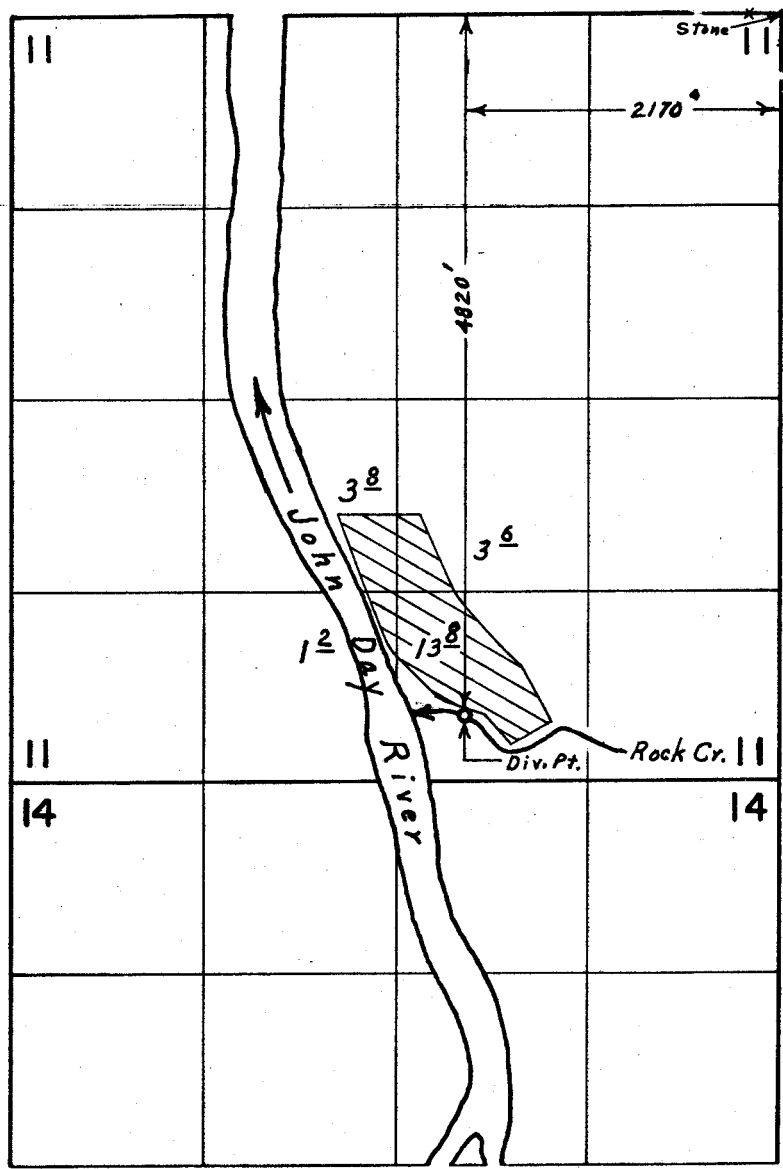

FINAL PROOF SURVEY UNDER

Application No. Transfer 2468
 Permit No.
 IN NAME OF
 V. O. WEST

Surveyed April 2, 1974, by L. E. Gould