T. 38S. R. 3W. W.M.

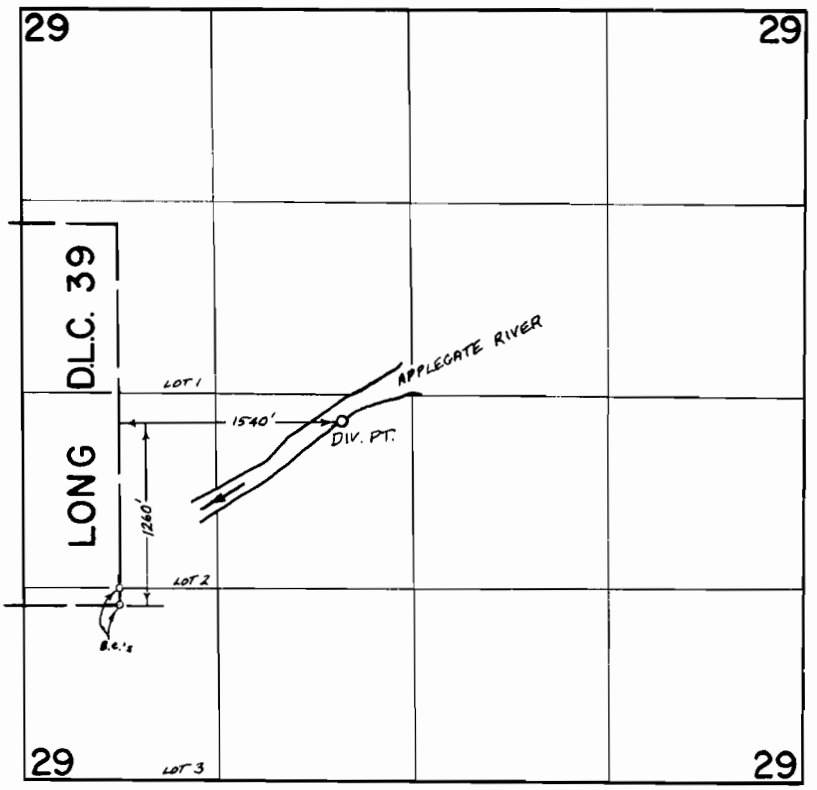

FINAL PROOF SURVEY
UNDER

TRANSFER NO. W-126

Application No. ..... Permit No. .....

IN NAME OF

EDWIN D. JONES

Surveyed AUG. 12 19 75, by L. TOLL

PTS-1975-W Pa