



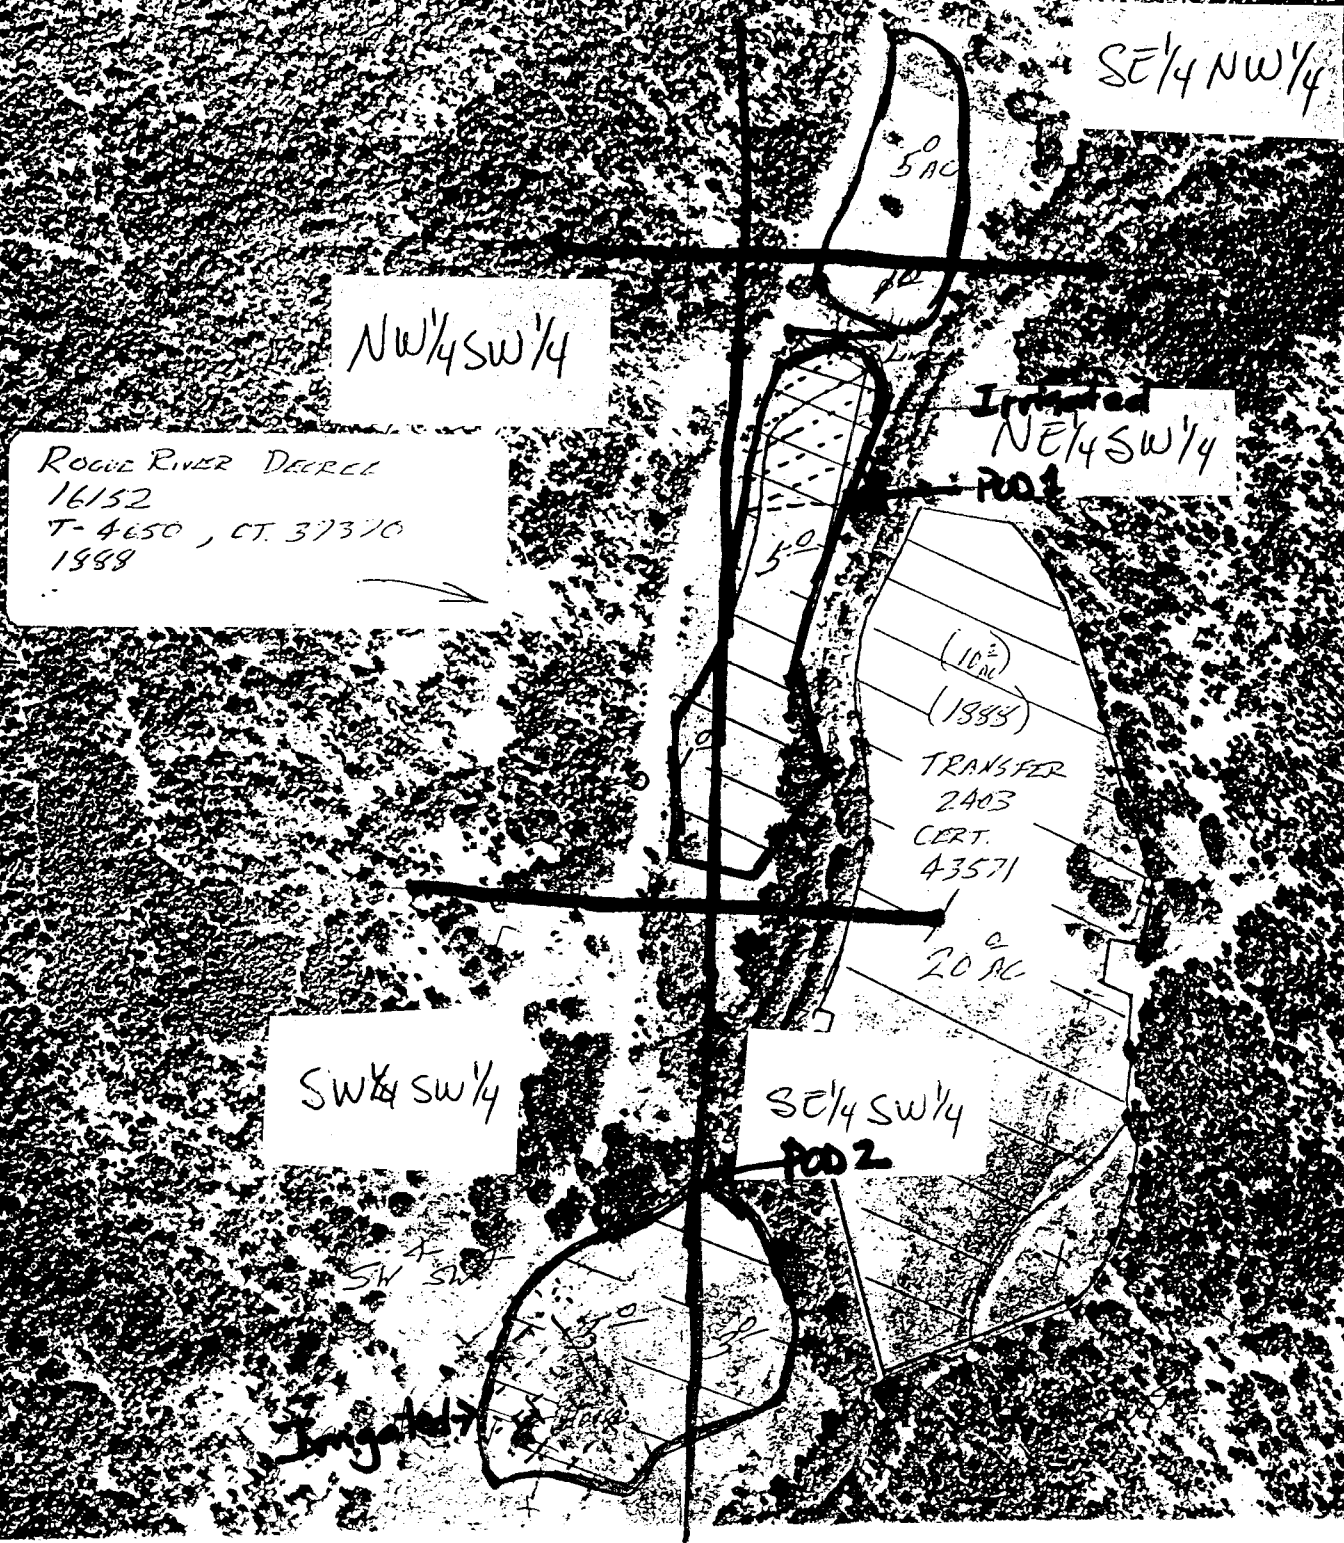

T. 34 S. R. 2 W. W.M.

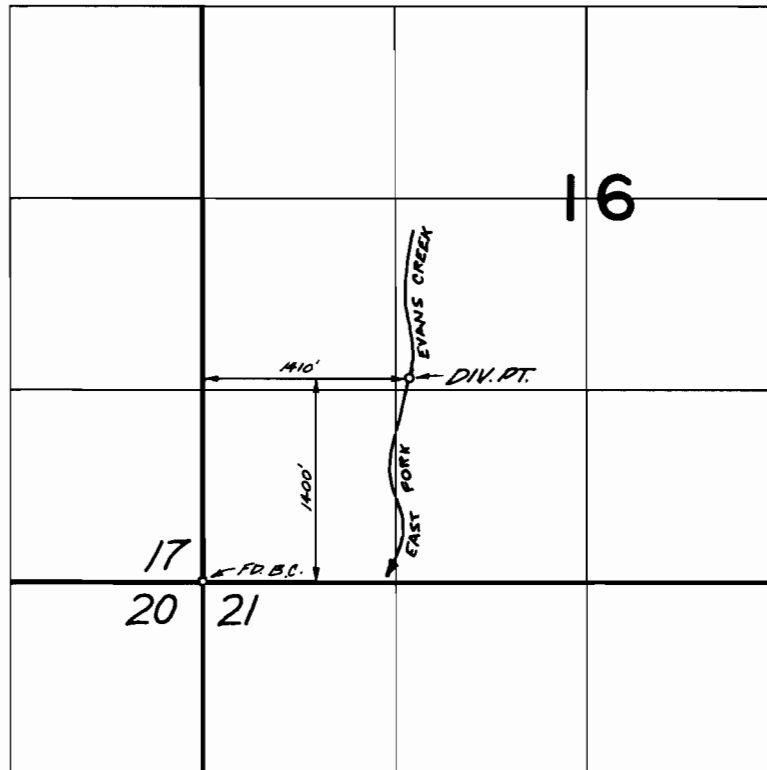

FINAL PROOF SURVEY
UNDER

TRANSFER No. 2403
Application No. Permit No.
IN NAME OF

MILO & FRANCES HANKS

Surveyed JULY 30 1974, by D. NORBY.....