


T.36 S.R.1&2 E.W.M.

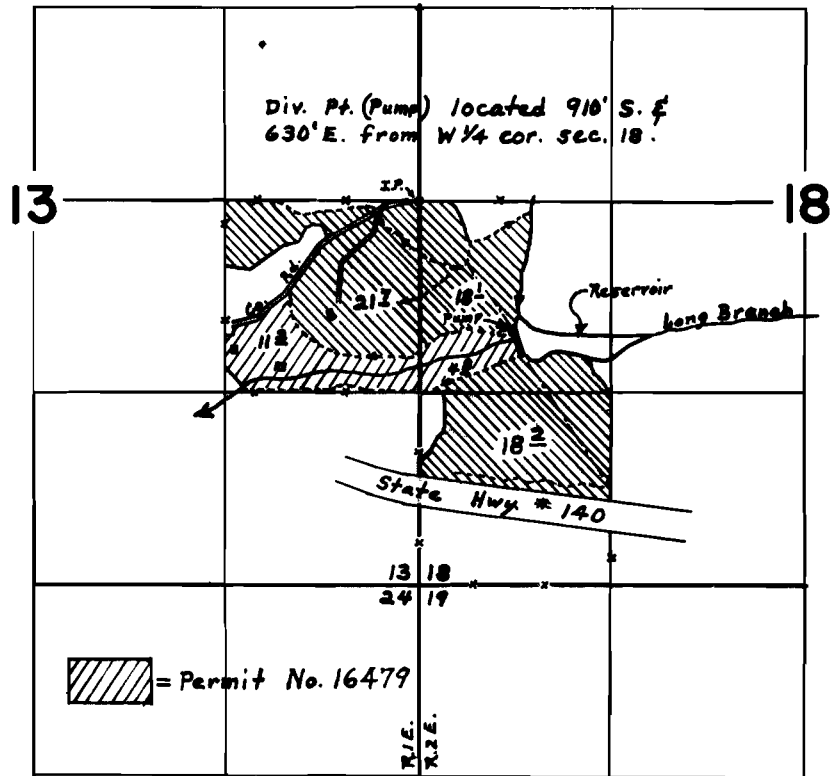

FINAL PROOF SURVEY UNDER

Application No. 30444 Permit No. 23906
R-30443 R-1803
 IN NAME OF

THEODORE BLOOMBERG, et al.

Surveyed May 24, 1967, by W. J. Ruppert
June 21, 1967 by D. L. Hendrix