


T.34S.R.IW.W.M.

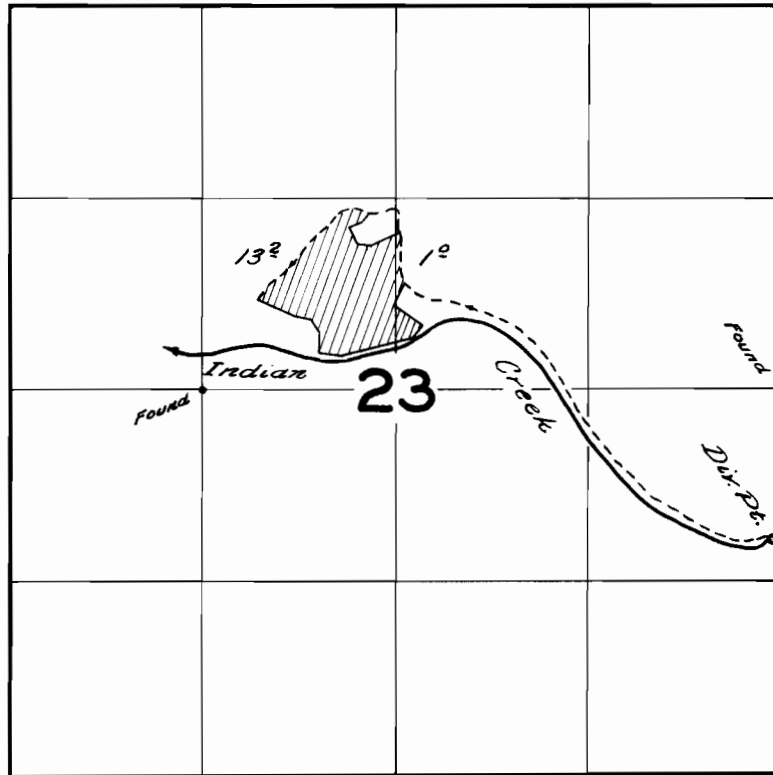

FINAL PROOF SURVEY UNDER

Application No. 28541... Permit No. 22330
IN NAME OF

.....*Charles L. Brewer*.....

Surveyed *May 9* 1959, by *C. O. Burt*