


Section 19

T. 40 S., R. 3 W., W. 1.

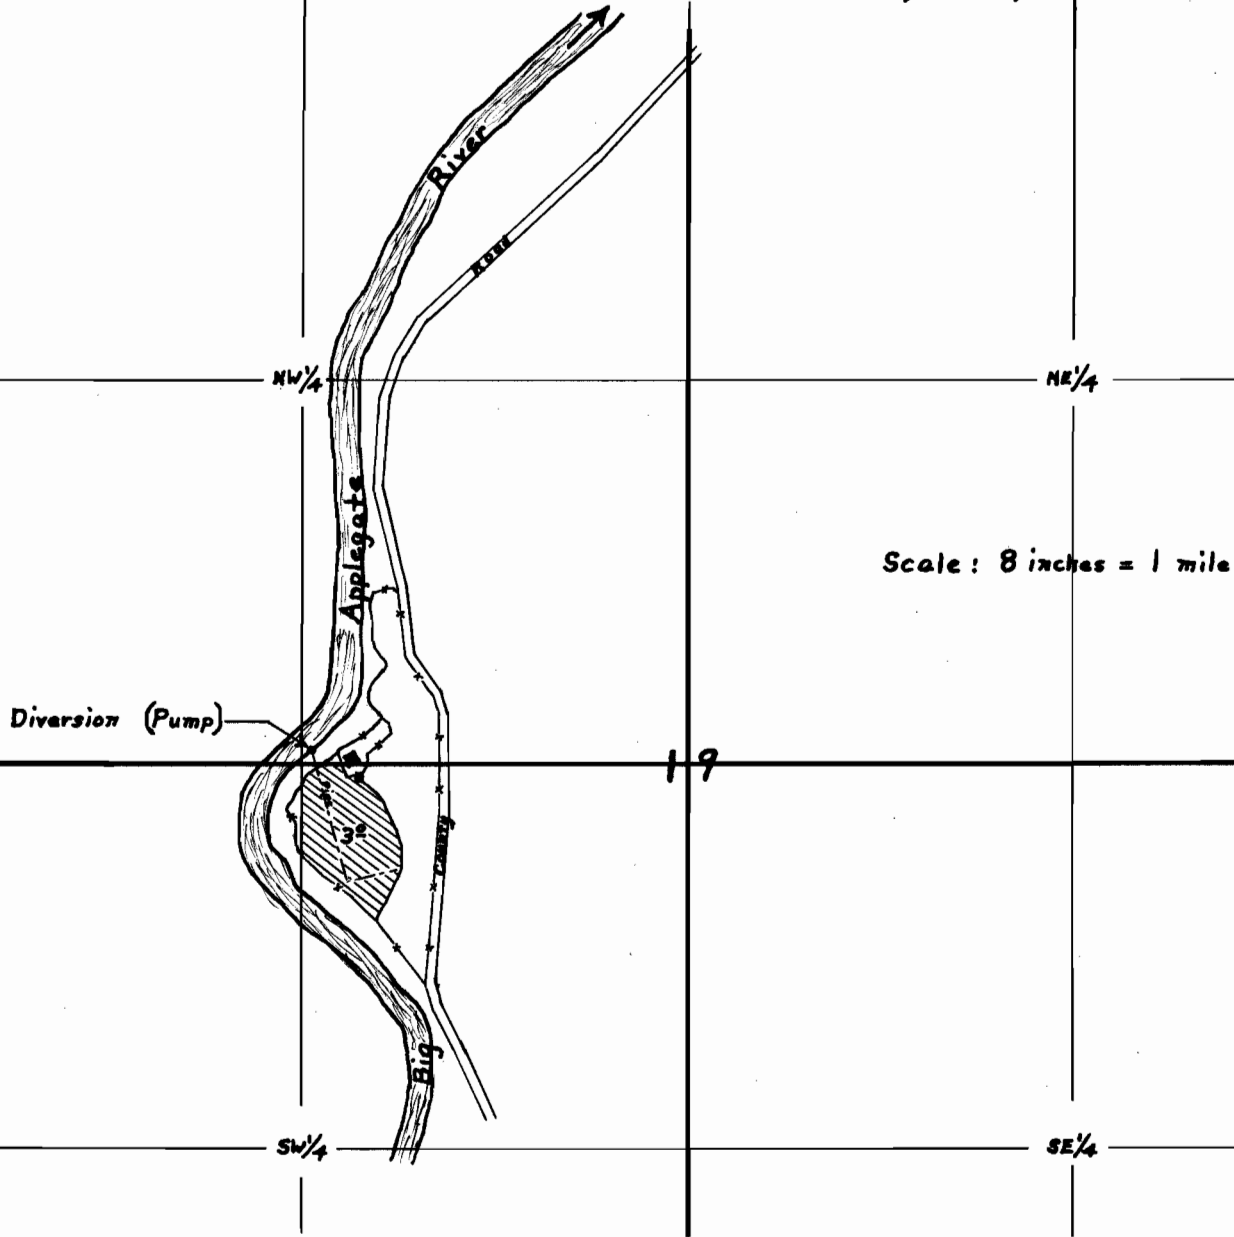

FINAL PROOF SURVEY

UNDER

Application No. **27627**... Permit No. **21761**.....

IN NAME OF

Gerald Buck

Surveyed March 16, 1956, by D.C. Hendrix, W.M.

RECEIVED
 MAR 28 1956
 STATE ENGINEER
 OREGON