


T.26S. R.4W. W.M.

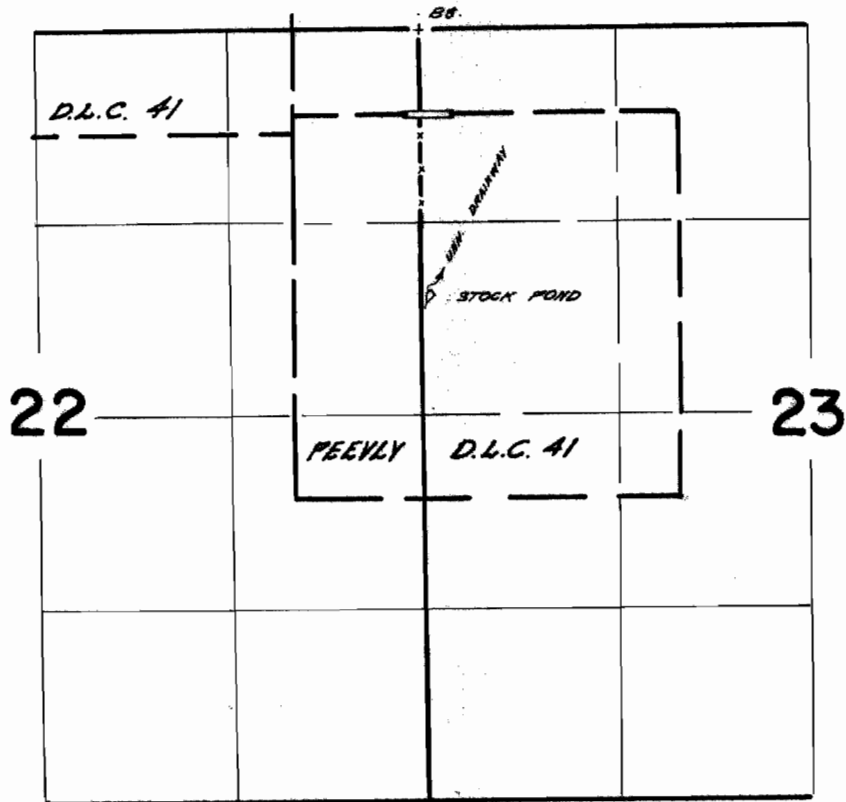

FINAL PROOF SURVEY
UNDER

Application No. *R-43596* Permit No. *R-5007*
IN NAME OF

FRANK AUSTIN

Surveyed *June 28 1968*, by *W.D. Ruppert*