


T. 28 S. R. 14 W. W.M.

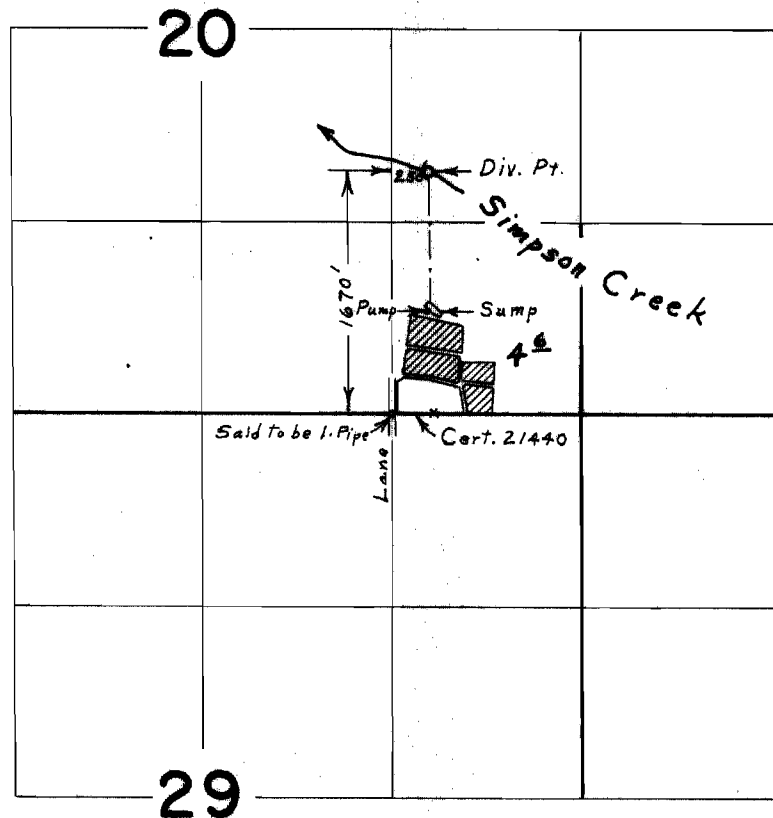

**FINAL PROOF SURVEY**  
UNDER

Application No. 43599 Permit No. 32599  
IN NAME OF

**RAYMOND H. SMITH**

Surveyed July 12, 1968, by L. E. Gould