


T. 11 S. R. 1 W. W.M.

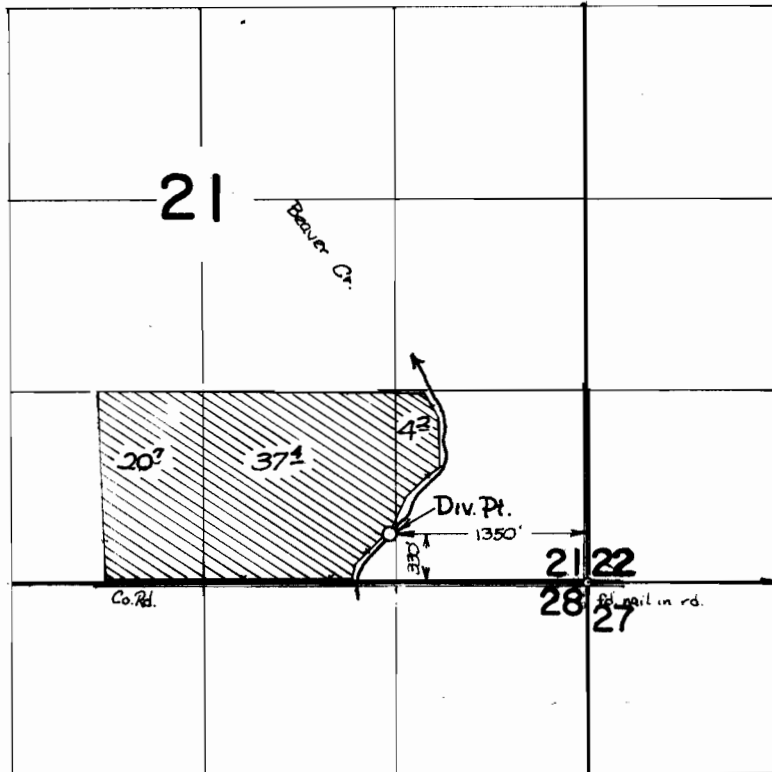

FINAL PROOF SURVEY

UNDER

Section No. 43084 Final No. 32187

IN NAME OF

BERT E. & JUNE M. SMEE

Surveyed 30 JULY 19 70 by D. R. BUELL