


T. 7S. R. 5W. WM

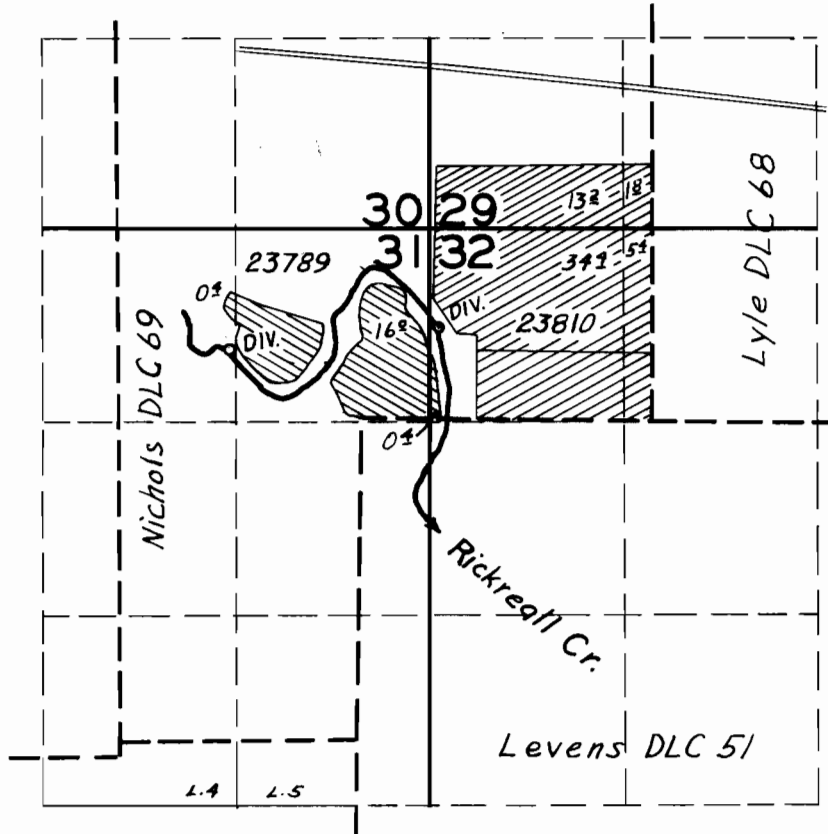

FINAL PROOF SURVEY

UNDER

Application No. 3739 Permit No. 10092
3810 35

IN NAME OF

J. B. Jordan

Carl Stonebrook

Surveyed Aug. 17 1954, by J. Jones

100-100
100-100