


T.9S. R.5W. W.M.

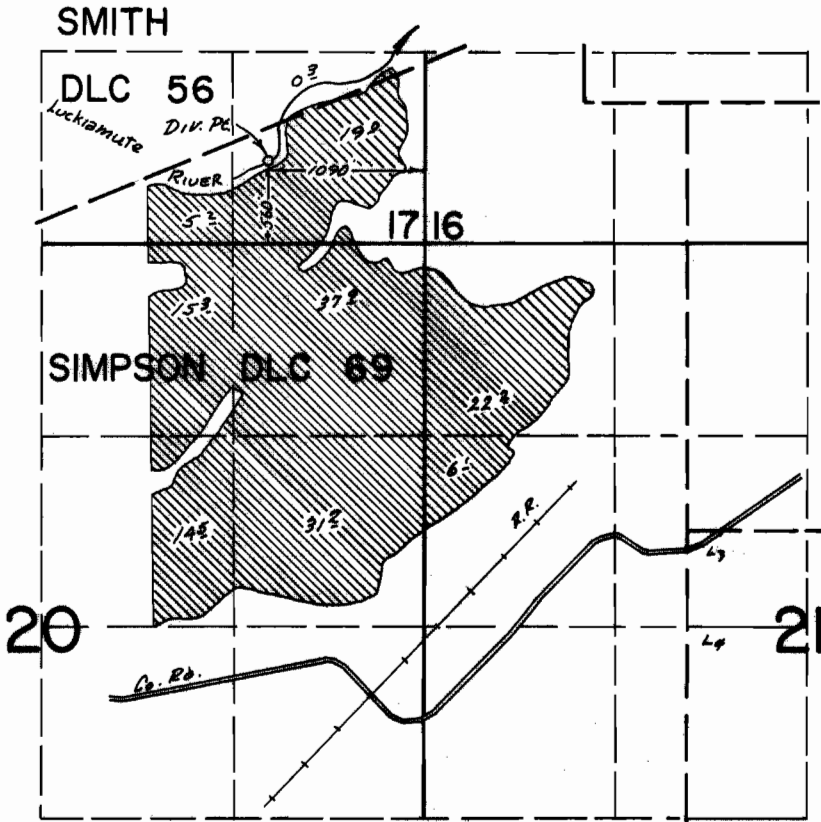

FINAL PROOF SURVEY
UNDER

Application No. 46612 Permit No. 34980

IN NAME OF

J. W. AUER

Surveyed March 22 19 99 by R. O. Mucken

