


T1S, R3W, W.M.

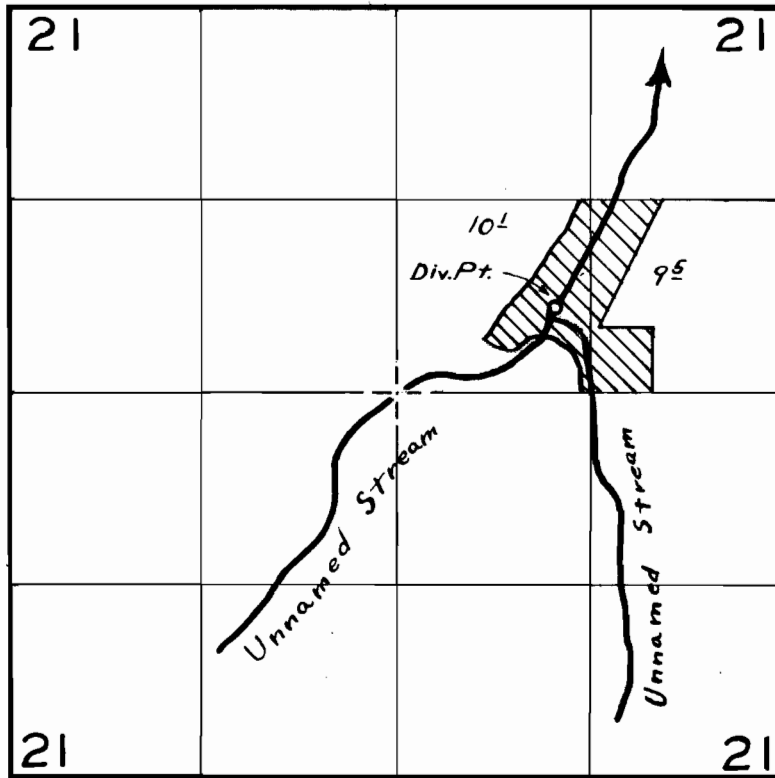

FINAL PROOF SURVEY

UNDER

Application No. 23142 Permit No. 18332

IN NAME OF

HENRY NEUMAN

Surveyed 5-3 1956, by R.D. BEST