



T.I.S.R.4W.W.M.

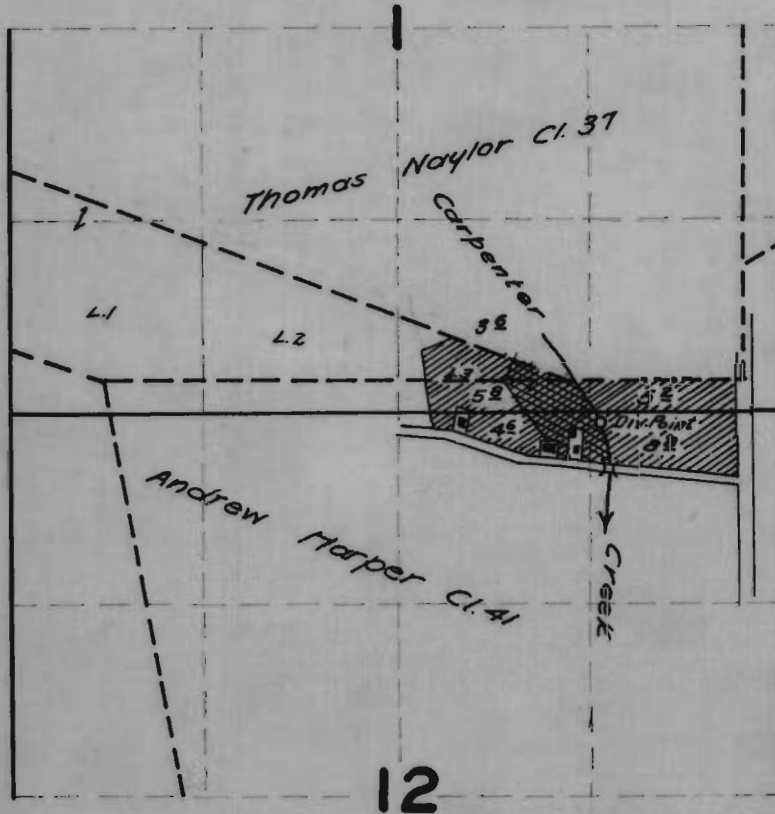

Cert. No. 14137 - 

FINAL PROOF SURVEY

UNDER

Application No. 22909 Permit No. 18003

IN NAME OF

FERDINAND LEMCKE

Surveyed 4 / 17 19 52, by H. L. COFFMAN