


T. 2 S., R. 2 W., W.M.

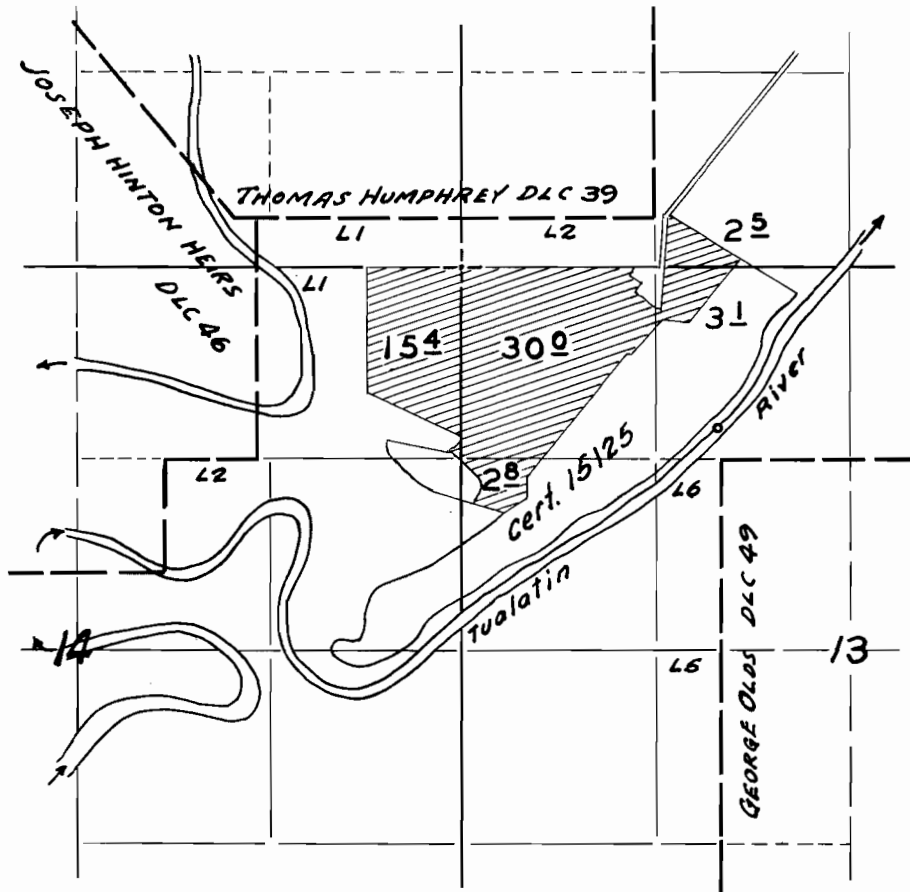

FINAL PROOF SURVEY

UNDER

Application No. 27101. Permit No. 21325
IN NAME OF

IRA MUILENBURG

Surveyed 5 - 8 1956, by M. BISH