


T.2S. R.2W. W.M.

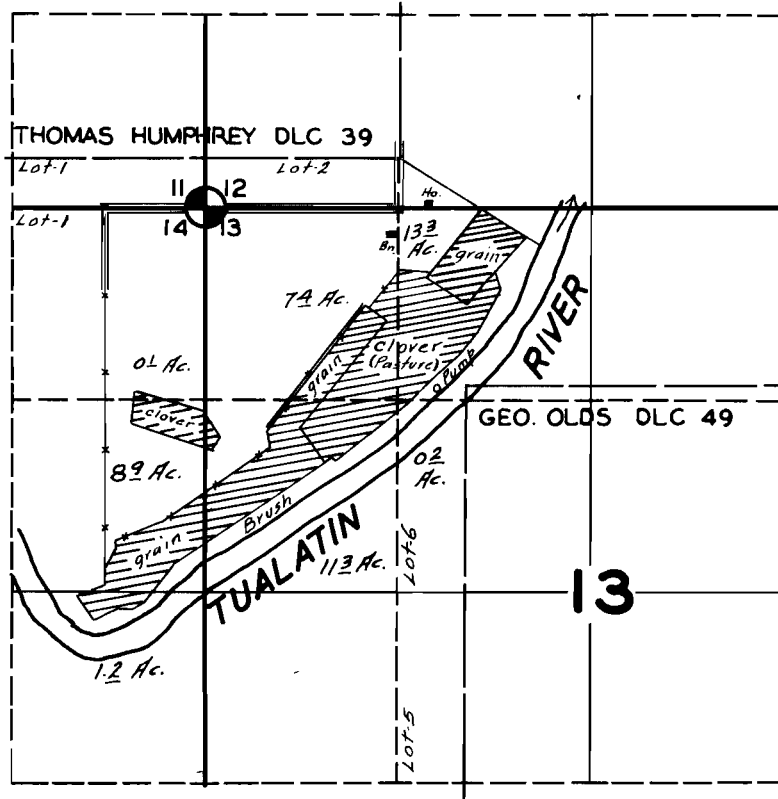

FINAL PROOF SURVEY UNDER

Application No. 19209 Permit No. 14802

IN NAME OF

IRA MUILENBURG

Surveyed AUG. 22 1944, by