


T.9S. R.40E. W.M.

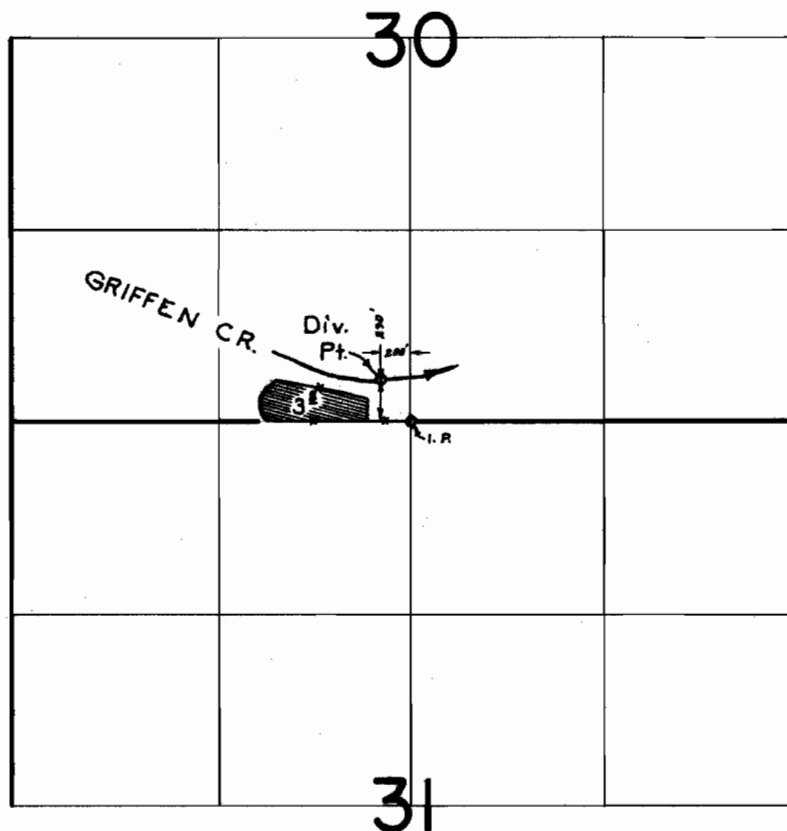

FINAL PROOF SURVEY
UNDER

Application No. 48133 Permit No. 36141
IN NAME OF

MARTIN VOYLES

Surveyed AUG. 21, 1975, by R. MUCKEN