


T.9S. R.46E. W. M.

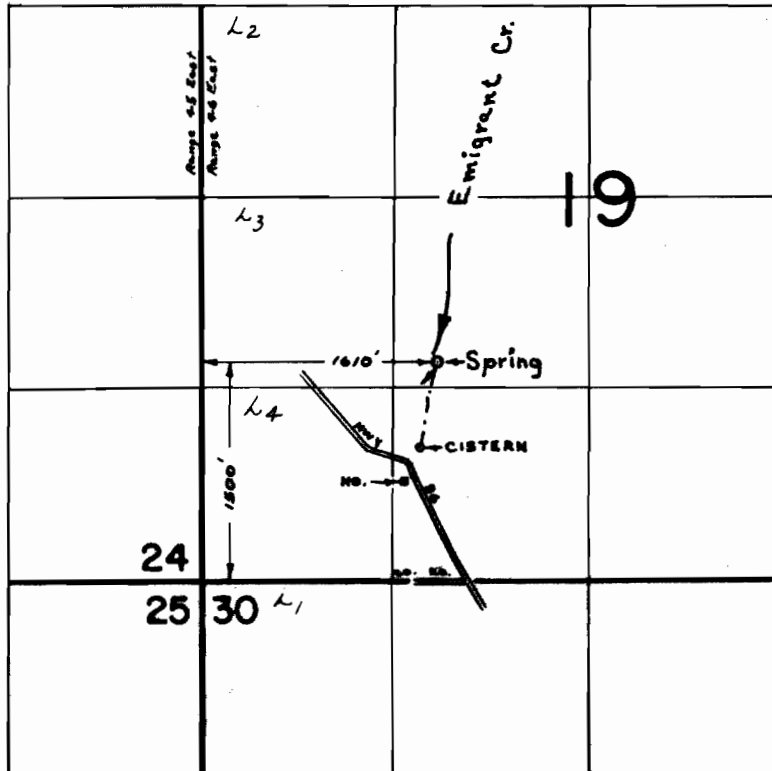

FINAL PROOF SURVEY UNDER

Application No. 49371 Permit No. 36157
IN NAME OF

WALTER P. &/OR OPAL A. WILLIAMS

Surveyed AUG. 27, 1975, by R. MUCKEN