


T.14 S., R.5 W., W.M.

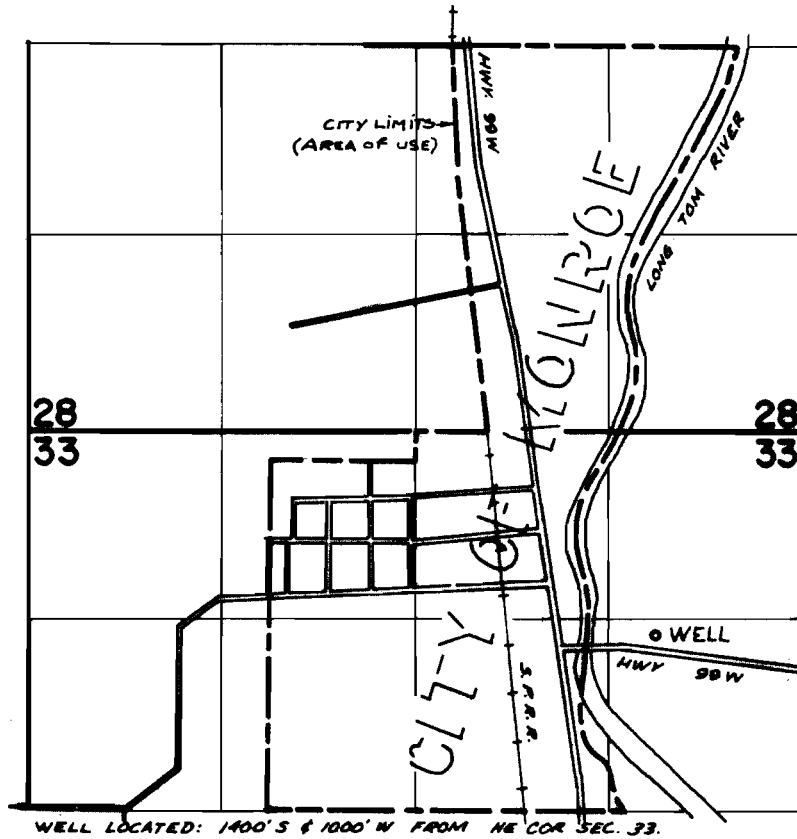

FINAL PROOF SURVEY
UNDER

Application No. G-4392 Permit No. G-4184
IN NAME OF

CITY OF MONROE

Surveyed APRIL 25 1973, by D. Noegy