


T.14S., R.8W., W.M.

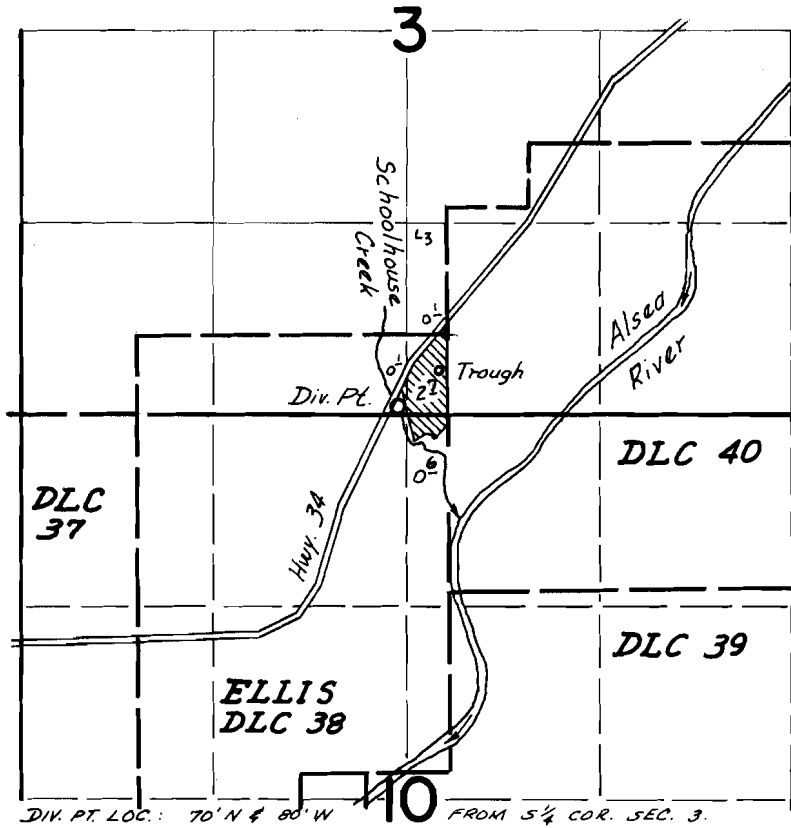

FINAL PROOF SURVEY
UNDER

Application No. 48535 Permit No. 36427
IN NAME OF

LEROY G. & JANET CLARK

Surveyed July 2 1975, by D. Norby