


T.13S., R.6W., W.M.

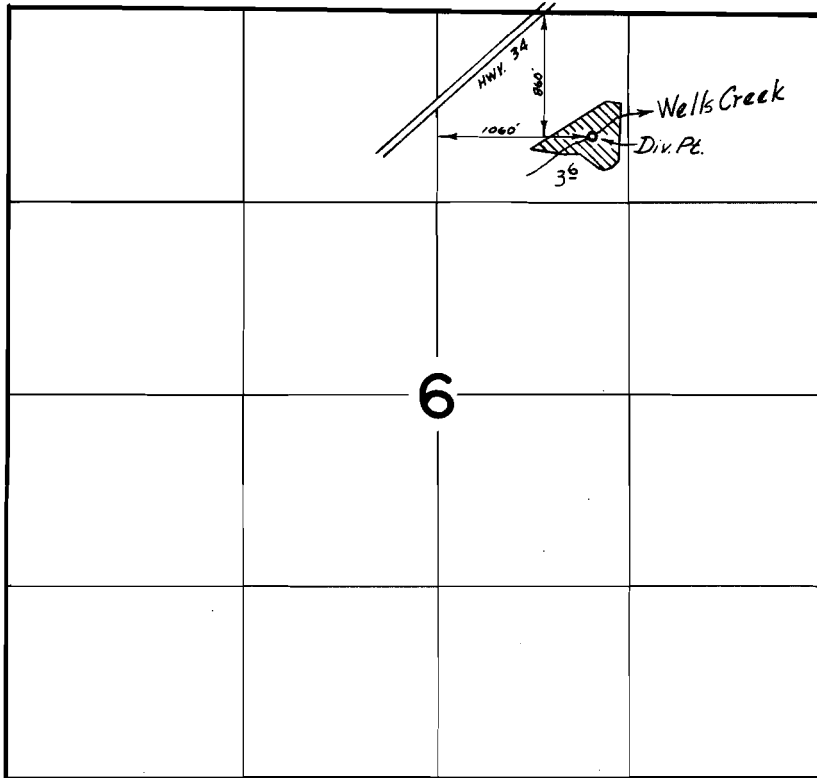

FINAL PROOF SURVEY
UNDER

Application No. 50104 Permit No. 37648
IN NAME OF

LEROY AND SLYVIA HIGHSMITH

Surveyed Aug. 15 1975, by D. Norby