


T. 2S. R. 6E. W.M.

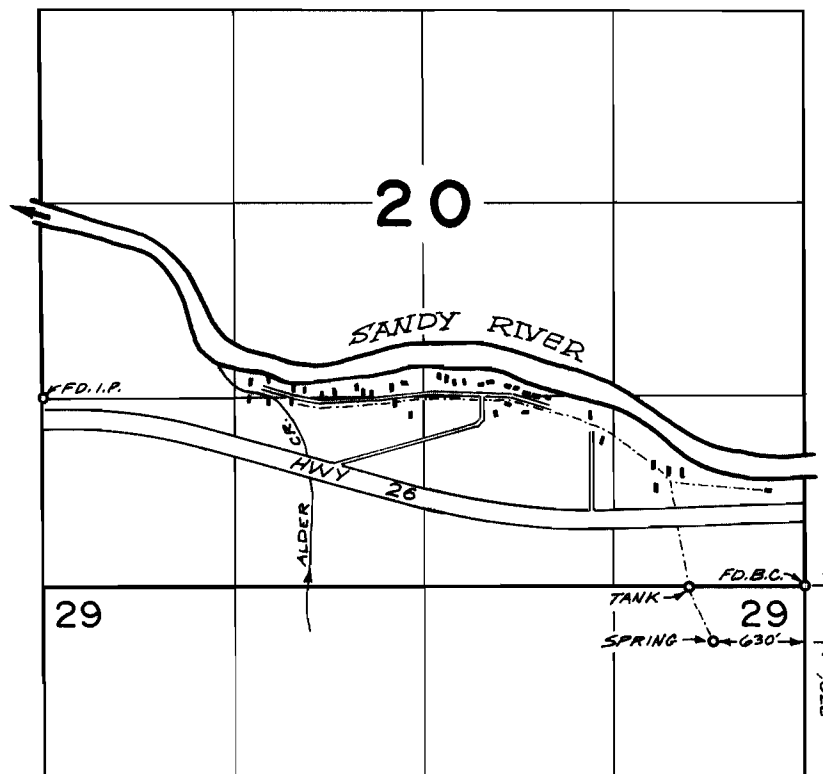

FINAL PROOF SURVEY
UNDER

Application No. 37417 Permit No. 27867
IN NAME OF
E. W. MORLAN

Surveyed SEPT. 25, 26 1975, by R.G. MUCKEN