


# T.4N.,R.7&8W.,W.M.

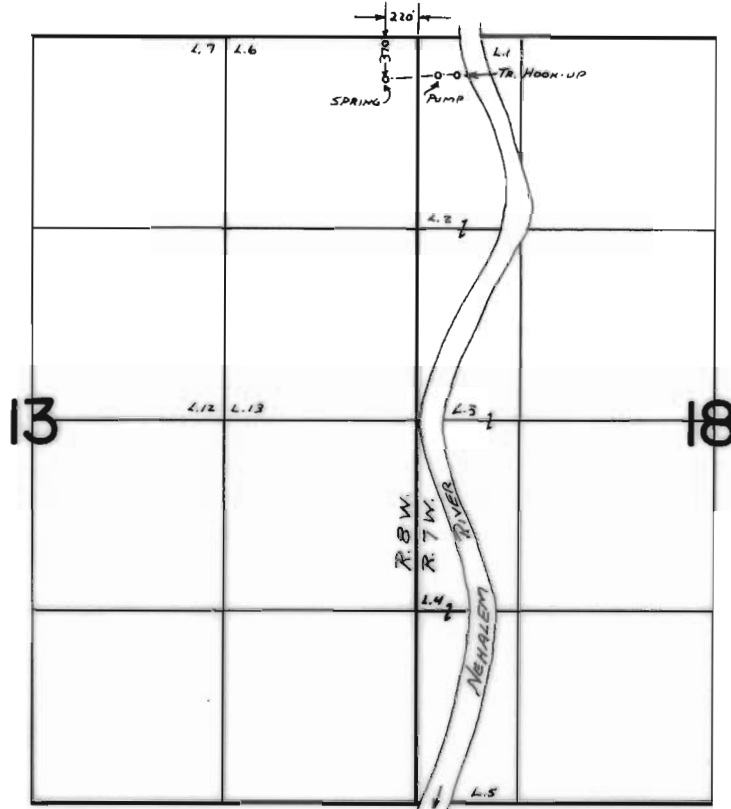

## FINAL PROOF SURVEY UNDER

Application No. 50955 Permit No. 37161  
IN NAME OF

RODNEY G. MARTIN

Surveyed SEPT 26 1975, by L. E. Gault