


T.6N., R.5W., W.M.

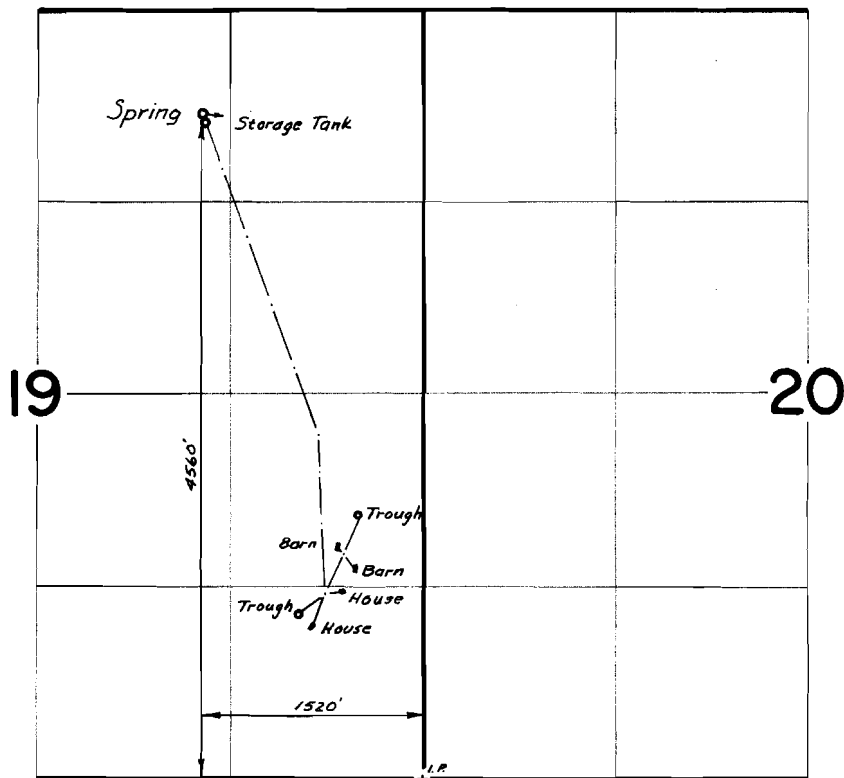

FINAL PROOF SURVEY UNDER

Application No. 50292 Permit No. 37378
IN NAME OF

E. T. JOHNSTON

Surveyed Oct. 2 1975, by D. Norby