


P-34299  
43642

# T.13S. R.31E. W.M.

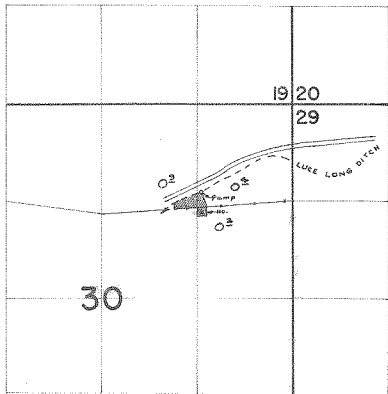

DIV. PT. FROM DONN DAY RIVER LOC: 1000' N. & 10' E. FROM S. 1/4 COR. SEC. 22  
SHOWN ON P.C. MAP APP. 34,120

## FINAL PROOF SURVEY UNDER

Application No. 45911 Permit No. 34299  
IN NAME OF  
RAMONA MORRIS

Surveyed JUNE 26, 1975, by R. MUCKEN