


12-35182
C-43643

T.13S., R.28E., W.M.

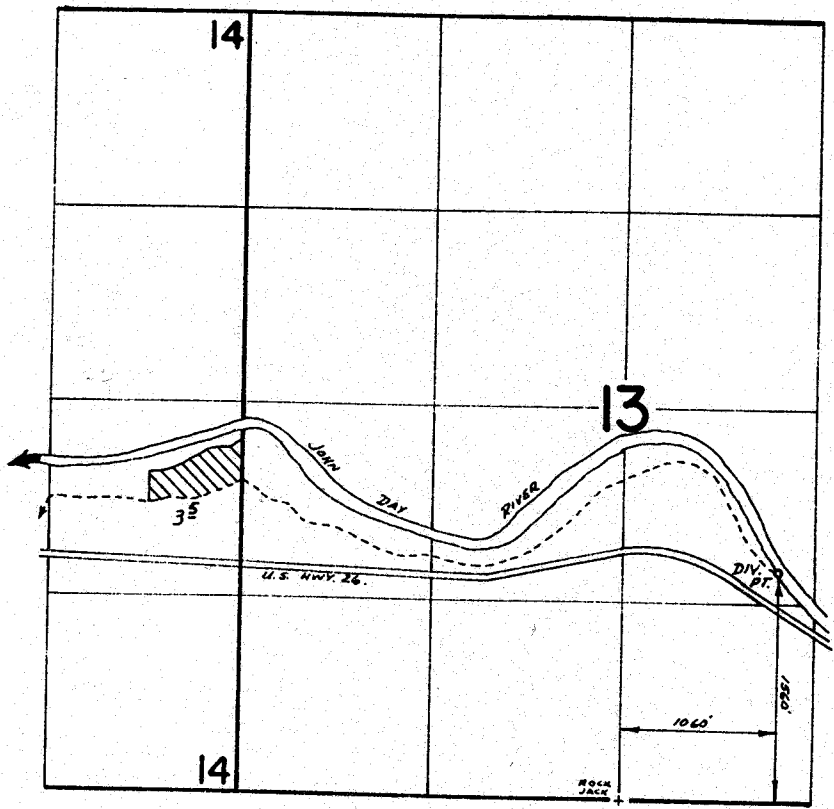

FINAL PROOF SURVEY
UNDER

Application No. 47037 Permit No. 35182
IN NAME OF
ESTATE OF GEO. E. BARRY
Surveyed June 21 1975, by D. Norby